

13V

CODED

CODED

Pearl River
X2
1-11-69

MISSISSIPPI
BOARD OF WATER COMMISSIONERS
416 North State Street
Jackson, Mississippi 39201

WATER WELL DRILLERS LOG

1-11-69 date well completed
Penton Well Serv firm name
Pearl River county well located

LANDOWNER: John Boyd
St. unknown

description of formations encountered	from	to
	Red Clay	0
SAND	16	22
Blue clay	22	68
Brown sand	68	82
Blue clay	82	197
silt	197	212
Blue Clay	212	320
Corey sand	320	363
Blue Clay	363	530
Corey sand	530	590
Blue Clay	590	640
Grey sand	640	695
Blue Clay	695	726
Grey sand	726	806

New Orleans La
(mailing address)

WELL LOCATION:
sec. 8 T. 6 N R. 16 E
S W
2 miles East of Picayune
(distance) (direction) (nearest town)

WELL PURPOSE: Home
(home, irrigation, municipal, industrial)

WELL COMPLETION DATA: 4 1/2 Drill

- (1) diameter (inches) 2"
- (2) total depth (feet) 806
- (3) static water level (feet) Flow below top of ground.
- (4) casing Black 786 (material) (depth) 2" Steel (size) if telescope see back.
- (5) screen 20' 786 (length) (depth to top) 2" S steel (size) (material)
- (6) pump NO 45 (HP) (yield gpm) NO (type power)
- (7) electric log NO (yes or no)
- (organization running log)
- (8) how well bottom plugged B.W. Valve

DRILLERS REMARKS:


CODED

FEB 3 1969

Miss. Bd. of Water Comm.

If well telescopes please sketch and show depths.

GROUND LEVEL

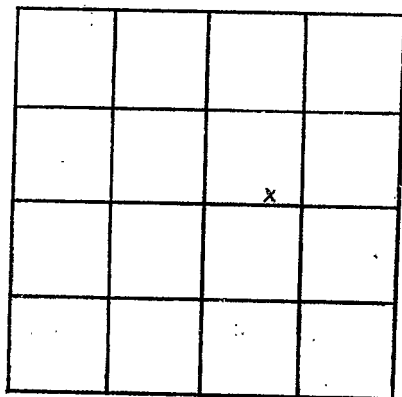

SECTION 8

Please indicate well location X.

ADDITIONAL INFORMATION

If more than one screen,
show locations of each on sketch.