

LODED  
CODED

CODED

Pearl River  
X 4  
3-8-69

MISSISSIPPI  
BOARD OF WATER COMMISSIONERS  
416 North State Street  
Jackson, Mississippi 39201

WATER WELL DRILLERS LOG

3-8 1969 Panton Well Serv Pearl River  
date well completed firm name county well located

LANDOWNER: Rickey Hickman  
Rt. 3 Box 390 A  
Picayune MISS  
(mailing address)

description of formations encountered	from	to
Surface Clay	0	21
Red sand	21	50
White clay	50	83
Blue clay	83	260
Grey sand	260	290

WELL LOCATION:  
sec. 10 T. 6 N. R. 16 W.  
4 miles East of Picayune  
(distance) (direction) (nearest town)

WELL PURPOSE: Home  
(home, irrigation, municipal, industrial)

- WELL COMPLETION DATA:
- (1) diameter (inches) 2
  - (2) total depth (feet) 290
  - (3) static water level (feet) 34 below top of ground.
  - (4) casing Cole  
(material) (depth)
  - 2" If telescope see back.  
(size)
  - (5) screen 5' 285'  
(length) (depth to top)
  - 2" S. Steel  
(size) (material)
  - (6) pump 1/2 7  
(HP) (yield gpm)
  - Elec  
(type power)
  - (7) electric log No  
(yes or no)

(organization running log)

(8) how well bottom plugged Be Valve

DRILLERS REMARKS:

CODED


CODED

MAR 17 1969

MISSISSIPPI  
STATE DEPT. OF  
WATER COMMISSIONERS

If well telescopes please sketch and show depths.

GROUND LEVEL

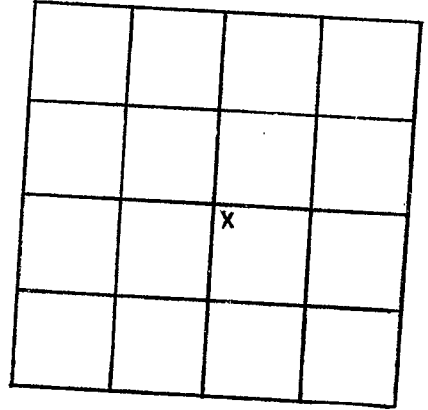

SECTION 10

Please indicate well location X.

ADDITIONAL INFORMATION

If more than one screen, show locations of each on sketch.