

Pearl River  
X.5  
4-17-69

MISSISSIPPI  
BOARD OF WATER COMMISSIONERS  
416 North State Street  
Jackson, Mississippi 39201

WATER WELL DRILLERS LOG

4-17 1969 Pontoni Well Serv Pearl River  
date well completed firm name county well located


LANDOWNER: <u>James B. Fisher</u> <u>New No Box</u> <u>Rt. 2</u>	description of formations encountered	from	to
<u>Carriere MISS</u> (mailing address)			
<b>WELL LOCATION:</b> sec. <u>8</u> T. <u>6</u> N. R. <u>16</u> E. S. W.	<u>SAND &amp; Gravel</u>	<u>18</u>	<u>80</u>
<u>1 1/2</u> miles <u>East</u> of <u>Picayune</u> (distance) (direction) (nearest town)	<u>Blue Clay</u>	<u>80</u>	<u>156</u>
<b>WELL PURPOSE:</b> <u>Home</u> (home, irrigation, municipal, industrial)	<u>Grey Sand</u>	<u>156</u>	<u>193</u>
<b>WELL COMPLETION DATA:</b> <u>4 1/2" Drilled</u>			
(1) diameter (inches) <u>2"</u>			
(2) total depth (feet) <u>193</u>			
(3) static water level (feet) <u>28'</u> below top of ground.			
(4) casing <u>Galv</u> , <u>187'</u> (material) (depth)			
<u>2"</u> (size) if telescope see back.			
(5) screen <u>5'</u> , <u>187'</u> (length) (depth to top)			
<u>2"</u> , <u>S. Steel</u> (size) (material)			
(6) pump <u>1/2</u> , <u>11</u> (HP) (yield gpm)			
<u>Elec</u> (type power)			
(7) electric log <u>NO</u> (yes or no)			
<u>(organization running log)</u>			
(8) how well bottom plugged <u>B.W. Value</u>			
<b>DRILLERS REMARKS:</b>			

MAY 29 1969  
MISS. BD. OF  
WATER COMM.

012

If well telescopes please sketch and show depths.

GROUND LEVEL

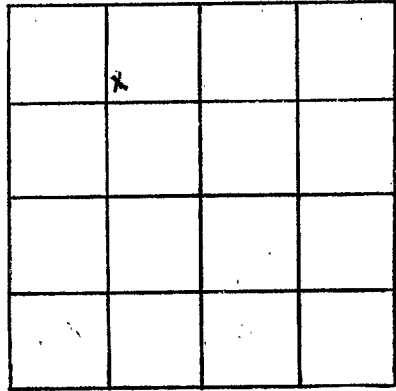

SECTION 8

Please indicate well location X.

ADDITIONAL INFORMATION

If more than one screen,  
show locations of each on sketch.