

Pearl River
X 6
5-7-69

MISSISSIPPI
 BOARD OF WATER COMMISSIONERS
 416 North State Street
 Jackson, Mississippi 39201

WATER WELL DRILLERS LOG

5-7 1969 Pentoni Well Serv Pearl River
 date well completed firm name county well located

LANDOWNER: George Stockst.
Rt. 2 Box 46
Carriere MISS
 (mailing address)

description of formations encountered	from	to
	<u>Red Clay</u>	<u>0</u>
<u>sand</u>	<u>16</u>	<u>38</u>
<u>Blue Clay</u>	<u>38</u>	<u>172</u>
<u>Grey Sand</u>	<u>172</u>	<u>195</u>

WELL LOCATION:
 sec. 6 T. 6 S. R. 16 W.
1 miles East of Picayune
 (distance) (direction) (nearest town)

WELL PURPOSE: Home
 (home, irrigation, municipal, industrial)

WELL COMPLETION DATA: 4 1/2 Drill

(1) diameter (inches) 2"

(2) total depth (feet) 195'

(3) static water level (feet) 41 below top of ground.

(4) casing Galv., 190,
 (material) (depth)
2" if telescope see back.
 (size)

(5) screen 5', 190
 (length) (depth to top)
2", S. Steel
 (size) (material)

(6) pump 1, 11.5
 (HP) (yield gpm)
Elec
 (type power)

(7) electric log NO
 (yes or no)

(organization running log)

(8) how well bottom plugged B.W. Value


DRILLERS REMARKS:

MAY 29 1969

MISS. BD. OF WATER COMMISSIONERS

If well telescopes please sketch and show depths.

GROUND LEVEL

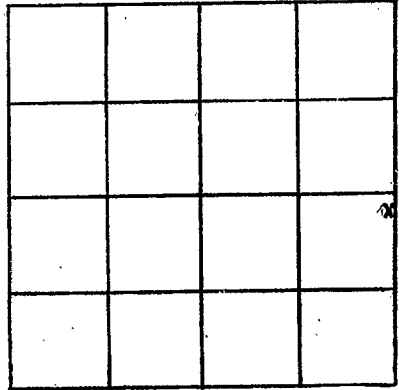

SECTION 6

Please indicate well location X.

ADDITIONAL INFORMATION

If more than one screen, show locations of each on sketch.