

Pearl River
X 7
6-3-69

MISSISSIPPI
 BOARD OF WATER COMMISSIONERS
 416 North State Street
 Jackson, Mississippi 39201

CODED

WATER WELL DRILLERS LOG

6-3 1969 Penlon well serv Pearl River
 date well completed firm name county well located

LANDOWNER: David Whitfield
New No Box
Rt. 3
Picayune Miss
 (mailing address)

description of formations encountered	from	to
Surface Clay	0	18
SAND	18	38
White clay	38	95
Brown Clay	95	132
Blue Clay	132	252
Grey SAND	252	278

WELL LOCATION:
 sec. 8 T 6 S R 16 E W
2 miles East of Picayune
 (distance) (direction) (nearest town)

WELL PURPOSE: Home
 (home, irrigation, municipal, industrial)


- WELL COMPLETION DATA:
- diameter (inches) 2"
 - total depth (feet) 278
 - static water level (feet) 43 below above top of ground.
 - casing Galv, 273,
 (material) (depth)
2" If telescope see back.
 (size)
 - screen 5', 273
 (length) (depth to top)
2", S. Steel
 (size) (material)
 - pump 1, 11
 (HP) (yield gpm)
Elec
 (type power)
 - electric log No
 (yes or no)
 (organization running log)
 - how well bottom plugged BW Valve

DRILLERS REMARKS:

APR 11 1969
 REG. OF GEOL. & WATER RES.

If well telescopes please sketch and show depths.

GROUND LEVEL

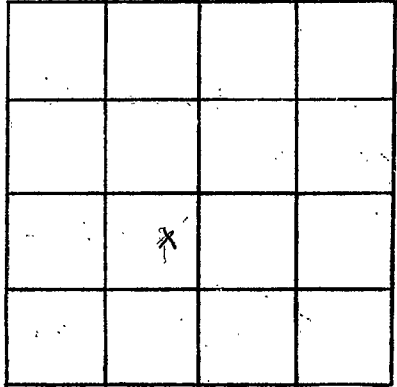

SECTION 9

Please indicate well location X.

ADDITIONAL INFORMATION

If more than one screen, show locations of each on sketch.