

Pearl River
X 8
6-69

MISSISSIPPI
BOARD OF WATER COMMISSIONERS
416 North State Street
Jackson, Mississippi 39201

WATER WELL DRILLERS LOG

6-28 1969 NEW LUMPKIN WELL DRILLING SERVICE Pearl River
date well completed P. O. BOX 117
CANTON, MISS. county well located

LANDOWNER: Lawrence W.
Haselmaier
Picayune, Route
(mailing address)

description of formations encountered	from	to
Surface Clay	0	15
" sand	15	65
Blue clay with sand streaks	65	550
Good sand	550	615

WELL LOCATION:
sec. 10 T. 6 N. R. 16 E.
5 miles East of Picayune
(distance) (direction) (nearest town)

WELL PURPOSE: home
(home, irrigation, municipal, industrial)

WELL COMPLETION DATA:

(1) diameter (inches) 7"

(2) total depth (feet) 615

(3) static water level (feet) 1 below above top of ground.

(4) casing galv. 609 (material) (depth)
2" (size) if telescope see back.

(5) screen 5' (length) (depth to top)
2" St. St. (size) (material)

(6) pump 3/4 700 gphv. (HP) (yield gpm)
electric (type power)

(7) electric log No. (yes or no)

(organization running log)


(8) how well bottom plugged back pressure valve

DRILLERS REMARKS:

JUL 1 1969
MISS. Bd. OF WATER COMMISSIONERS

If well telescopes please
sketch and show depths.

GROUND LEVEL

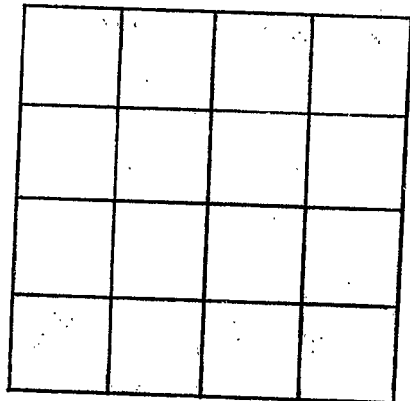

SECTION _____

Please indicate well location X.

ADDITIONAL INFORMATION

If more than one screen,
show locations of each on sketch.