

CODED

MISSISSIPPI  
BOARD OF WATER COMMISSIONERS  
416 North State Street  
Jackson, Mississippi 39201

WATER WELL DRILLERS LOG

ARTHUR LUMPKIN WELL DRILLING SERVICE  
P. O. BOX 117

*Pearl River*

7-1 1969  
date well completed

GARRETT, MISS.

county well located

LANDOWNER: *Brooks Mitchell*

description of formations encountered from to

*Picayune Route*  
(mailing address)

*Surface clay* 0 18  
*" sand* 18 45

WELL LOCATION:  
sec. 16 T. 6 N. R. 16 E.  
4 miles East of Picayune  
(distance) (direction) (nearest town)

*Blue clay/sand streaks* 45 220  
*Good sand, fine to better* 220 297

WELL PURPOSE: *Home*  
(home, irrigation, municipal, industrial)

WELL COMPLETION DATA:

- (1) diameter (inches) 2"
- (2) total depth (feet) 297'
- (3) static water level (feet) 40 below  
top of ground. above
- (4) casing galv. 291  
(material) (depth)  
2" if telescope see back.  
(size)
- (5) screen 51  
(length) (depth to top)  
2" St. Steel  
(size) (material)
- (6) pump 1 650 per hr.  
(HP) (yield/gpm)  
electric  
(type power)
- (7) electric log No.  
(yes or no)

(organization running log)

(8) how well bottom plugged back  
pressure valve


DRILLERS REMARKS:

JUN 24 1969

MISSISSIPPI  
BOARD OF WATER COMMISSIONERS

If well telescopes please  
sketch and show depths.

GROUND LEVEL

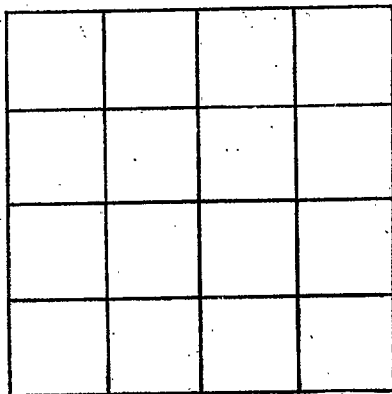

SECTION \_\_\_\_\_

Please indicate well location X.

ADDITIONAL INFORMATION

If more than one screen,  
show locations of each on sketch.