

PEARL RIVER
 X 12
 7-16-69

MISSISSIPPI
 BOARD OF WATER COMMISSIONERS
 416 North State Street
 Jackson, Mississippi 39201

CODED

WATER WELL DRILLERS LOG

NEIL LUMPKIN WELL DRILLING SERVICE
 P. O. BOX 117
 CARLIERE, MISS.

Pearl River
 county well located

7-16-1969
 date well completed

Drill name

LANDOWNER: *Geo. J. (Bonnie)*
Picayune, Miss.

description of formations encountered

from to

(mailing address)

WELL LOCATION:

sec. 7 T. 6 S. R. 16 W.
5 miles East of Picayune
 (distance) (direction) (nearest town)

WELL PURPOSE: home
 (home, irrigation, municipal, industrial)

WELL COMPLETION DATA:

- (1) diameter (inches) 2"
- (2) total depth (feet) 980'
- (3) static water level (feet) 40 ^{below} above top of ground.
- (4) casing plk.
 (material) (depth)
2"
 (size) if telescope see back.
- (5) screen 20
 (length) (depth to top)
2" St Steel
 (size) (material)
- (6) pump 60 gpm
 (HP) (yield gpm)
 (type power)
- (7) electric log no.
 (yes or no)
 (organization running log)

<i>Surface Clay</i>	0	10
<i>Sand</i>	10	30
<i>Blue Clay</i>	30	140
<i>Sand</i>	140	250
<i>Blue Clay</i>	250	340
<i>Sand</i>	340	400
<i>Blue Clay</i>	400	670
<i>Sand</i>	670	685
<i>Clay</i>	685	870
<i>Sand</i>	870	980


DRILLERS REMARKS:
18 lbs. pressure

MISS. DE. OF WATER CONTROL

10 1969

If well telescopes please sketch and show depths.

GROUND LEVEL

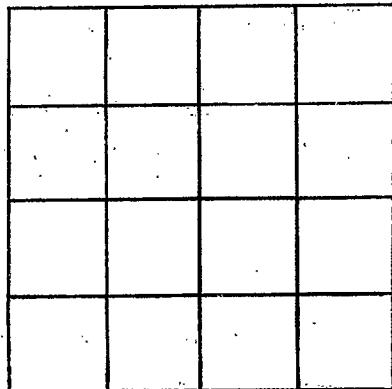

SECTION _____

Please indicate well location X.

ADDITIONAL INFORMATION

If more than one screen, show locations of each on sketch.