

Peal River
X 13
12-8-69

MISSISSIPPI
 BOARD OF WATER COMMISSIONERS
 416 North State Street
 Jackson, Mississippi 39201

CODED. CODED

69 WATER WELL DRILLERS LOG

12-8 1969 Pealton Well Serv Peal River
 date well completed firm name county well located

LANDOWNER: Ray Champagne
Rt 3 Box 50
Picayune Miss
 (mailing address)

description of formations encountered	from	to
Red Clay	0	18
Sand	18	65
Red Clay	65	80
yellow sand	80	128
Blue Clay	128	285
Fine sand	285	315
Blue Clay	315	365
Grey sand	365	405

WELL LOCATION:
 sec. 16 T. 6 R. 16
 S W
2 miles East of Picayune
 (distance) (direction) (nearest town)

WELL PURPOSE: Home
 (home, irrigation, municipal, industrial)

- WELL COMPLETION DATA:
- (1) diameter (inches) 2
 - (2) total depth (feet) 405
 - (3) static water level (feet) 50 below above top of ground.
 - (4) casing Galv 400
 (material) (depth)
2" if telescope see back.
 (size)
 - (5) screen 5' 400
 (length) (depth to top)
2" S. steel
 (size) (material)
 - (6) pump 1 650
 (HP) (yield gpm)
Elec
 (type power)
 - (7) electric log NO
 (yes or no)

D12

(organization running log)

JAN 12 1970


(8) how well bottom plugged BU Valve

MISS. Bd. OF WATER COMM.

DRILLERS REMARKS:

If well telescopes please sketch and show depths.

GROUND LEVEL

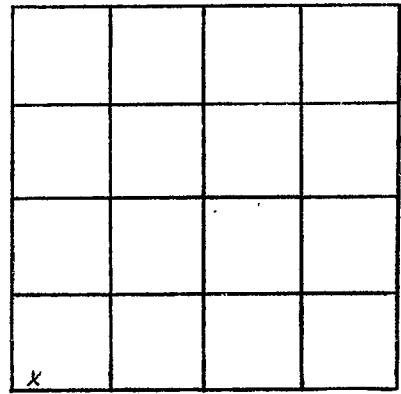

SECTION 16

Please indicate well location X.

ADDITIONAL INFORMATION

If more than one screen, show locations of each on sketch.