

Pearl River
 X 14
 1-9-70

MISSISSIPPI
 BOARD OF WATER COMMISSIONERS
 416 North State Street
 Jackson, Mississippi 39201

CODED

WATER WELL DRILLERS LOG


1-9-70 19 E. J. Water Well Serv. Pearl River
 date well completed firm name county well located

LANDOWNER:	description of formations encountered	from	to
Jack White Field.			
Sy Camore Rt 1 Pragnone (mailing address)	Coarse white sd. & chert	16	50
	Red Clay	50	85
	white clay	85	105
WELL LOCATION:	Red Fine sand.	105	132
sec. 6 T. 6 N. R. 16 E S. W.	Blue clay	132	148
2 miles East of Roseland (distance) (direction) (nearest town)	Fine Gray sd.	148	153
WELL PURPOSE:	Blue clay	153	175
(home, irrigation, municipal, industrial)	Fine Gray sand	175	181
WELL COMPLETION DATA:	Blue clay	181	199
(1) diameter (inches) 4.5	Fine Gray sand	199	208
(2) total depth (feet) 257	Blue clay	208	214
(3) static water level (feet) 32 below top of ground.	medium coarse sd.	214	257
(4) casing 2" Galv. 252 (material) (depth)			
(size) if telescope see back.			
(5) screen 5' 252 (length) (depth to top)			
2" 5.5. (size) (material)			
(6) pump 1 410 H.P. (HP) (yield gpm)			
Elect (type power)			
(7) electric log NO (yes or no)			
(organization running log)			
(8) how well bottom plugged Shoe			
DRILLERS REMARKS:			

FEB 26 1970
 MISS. Bd. OF
 WATER COMM.

If well telescopes please sketch and show depths.

GROUND LEVEL

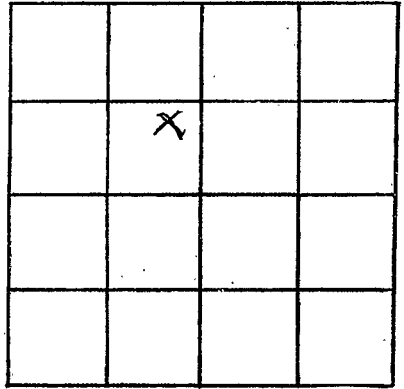

SECTION 6

Please indicate well location X.

ADDITIONAL INFORMATION

If more than one screen,
show locations of each on sketch.