

Pearl River  
 X 16  
 2-6-70

MISSISSIPPI  
 BOARD OF WATER COMMISSIONERS  
 416 North State Street  
 Jackson, Mississippi 39201

CODED

WATER WELL DRILLERS LOG

Pearl River

2-6 date well completed      19 70 Pentoni Well Serv firm name      Pearl River county well located

LANDOWNER: A. V. Werner  
Rt. 1 Box 283  
Picayune Miss  
 (mailing address)

description of formations encountered	from	to
Surface Clay	0	22
Red sand	22	88
Blue Clay	88	180
yellow sand	180	218
Blue Clay	218	338
Corey sand	338	398

WELL LOCATION:  
 sec. 13 T 6 R 16  
6 miles East of Picayune  
 (distance) (direction) (nearest town)

WELL PURPOSE: Home  
 (home, irrigation, municipal, industrial)

WELL COMPLETION DATA: 4 1/2

(1) diameter (inches) 2"

(2) total depth (feet) 398

(3) static water level (feet) 29 below top of ground.

(4) casing Coalu, 393,  
 (material) (depth)  
2" if telescope see back.  
 (size)

(5) screen 5', 393  
 (length) (depth to top)

.012 2", St. Steel  
 (size) (material)

(6) pump 1/2 10  
 (HP) (yield gpm)

Elec  
 (type power)

(7) electric log No  
 (yes or no)

(organization running log)

(8) how well bottom plugged B.W. Value


FEB 25 1970

MISS. BD. OF  
 WATER COMMISSIONERS

DRILLERS REMARKS:

If well telescopes please sketch and show depths.

GROUND LEVEL

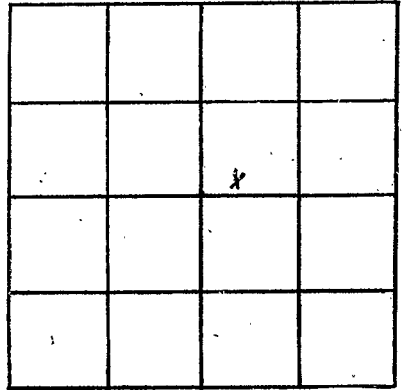

SECTION 13

Please indicate well location X.

ADDITIONAL INFORMATION

If more than one screen, show locations of each on sketch.