

Pearl River  
 X 18  
 4-21-70

MISSISSIPPI  
 BOARD OF WATER COMMISSIONERS  
 416 North State Street  
 Jackson, Mississippi 39201

WATER WELL DRILLERS LOG

4-21 1970 Penton Well Serv Pearl River  
 date well completed firm name county well located

LANDOWNER: Milton Necaize  
 318 Vaughn  
 Picayune MISS  
 (mailing address)

| description of formations encountered | from | to  |
|---------------------------------------|------|-----|
| Surface Clay                          | 0    | 24  |
| Sand                                  | 24   | 36  |
| Blue clay                             | 36   | 48  |
| Silt                                  | 48   | 65  |
| Blue clay                             | 65   | 153 |
| Grey sand                             | 153  | 240 |
| Blue clay                             | 240  | 335 |
| Grey sand                             | 335  | 358 |
| Blue clay                             | 358  | 445 |
| Silt                                  | 445  | 455 |
| Blue Clay                             | 455  | 680 |
| Grey sand                             | 680  | 730 |
| Hard Blue Clay                        | 730  | 738 |
| Grey sand                             | 738  | 810 |
| Blue clay                             | 810  | 925 |
| Grey sand                             | 925  | 986 |

WELL LOCATION:  
 sec. 8 T. 6 R. 16  
 1 miles East of Picayune  
 (distance) (direction) (nearest town)

WELL PURPOSE: Home  
 (home, irrigation, municipal, industrial)


WELL COMPLETION DATA:  
 (1) diameter (inches) 2  
 (2) total depth (feet) 986  
 (3) static water level (feet) Flow above top of ground.  
 (4) casing Black, 966  
 (material) (depth)  
 2 if telescope see back.  
 (size)  
 (5) screen 20', 966  
 (length) (depth to top)  
 2, S. steel  
 (size) (material)  
 (6) pump (HP) (yield gpm)  
 (type power)  
 (7) electric log NO  
 (yes or no)  
 (organization running log)  
 (8) how well bottom plugged BW Valve

DRILLERS REMARKS: 18 lbs - Pressure

EX-107 5 370

If well telescopes please sketch and show depths.

GROUND LEVEL

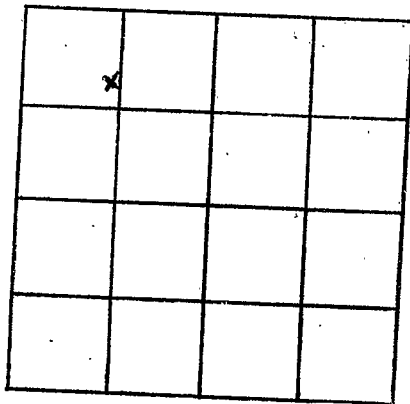

SECTION 8

Please indicate well location X.

ADDITIONAL INFORMATION

If more than one screen, show locations of each on sketch.