

Pearl River  
X 19  
4-11-70

MISSISSIPPI  
 BOARD OF WATER COMMISSIONERS  
 416 North State Street  
 Jackson, Mississippi 39201

WATER WELL DRILLERS LOG  
 NEEL LUMPKIN WELL DRILLING SERVICE

P. O. BOX 117  
 CARRIER, MISS.

Pearl River

4-11 1970  
 date well completed

firm name

county well located


LANDOWNER: <u>Mike Tenton Jr.</u>	description of formations encountered	from	to
<u>Picayune</u>	<u>Surface Clay</u>	<u>0</u>	<u>10</u>
<u>Route</u> (mailing address)	<u>Surface sand, good</u>	<u>10</u>	<u>80</u>
WELL LOCATION: sec. <u>8</u> T. <u>6</u> R. <u>16</u> <u>074</u>	<u>Clay</u>	<u>80</u>	<u>150</u>
<u>5</u> miles <u>East</u> of <u>Picayune</u> (distance) (direction) (nearest town)	<u>Sand</u>	<u>150</u>	<u>200</u>
WELL PURPOSE: <u>home</u> (home, irrigation, municipal, industrial)	<u>Clay</u>	<u>200</u>	<u>450</u>
WELL COMPLETION DATA:	<u>Perfect pump well</u>	<u>450</u>	<u>550</u>
(1) diameter (inches) <u>2"</u>	<u>Clay</u>	<u>550</u>	<u>900</u>
(2) total depth (feet) <u>1008</u>	<u>Sand</u>	<u>700</u>	<u>780</u>
(3) static water level (feet) <u>35</u> <sup>below</sup> above top of ground.	<u>Heaving shales</u>	<u>780</u>	<u>930</u>
(4) casing <u>blk</u> <u>42' galv. on top</u> (material) (depth)	<u>fine to better sand</u>	<u>930</u>	<u>1008</u>
<u>2"</u> If telescope see back. (size)			
(5) screen <u>20'</u> (length) (depth to top)			
<u>2"</u> <u>St. Steel</u> (size) (material)			
(6) pump _____ (HP) _____ (yield gpm)			
(type power)			
(7) electric log <u>no</u> (yes or no)			
(organization running log)			
(8) how well bottom plugged <u>Johnson</u> <u>back pressure valve</u>			
DRILLERS REMARKS: <u>15 lbs. pressure</u>			

APR 11 1970

MISS. Bd. of WATER COMMISSIONERS

If well telescopes please sketch and show depths.

GROUND LEVEL

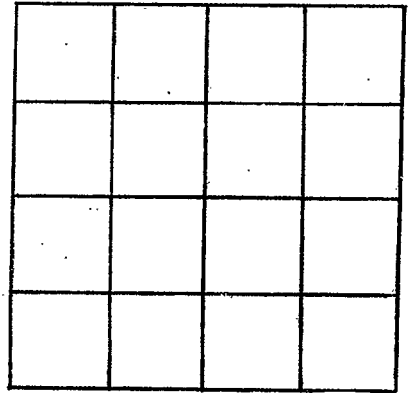

SECTION \_\_\_\_\_

Please indicate well location X.

ADDITIONAL INFORMATION

If more than one screen, show locations of each on sketch.