

PEARL RIVER
X 20
8-14-70

MISSISSIPPI
BOARD OF WATER COMMISSIONERS
416 North State Street
Jackson, Mississippi 39201

CODED

WATER WELL DRILLERS LOG

8-14 date well completed 1970 Penton Well Serv Pearl River firm name county well located

LANDOWNER: M. J. - Boudin
Rty 2
Picayune MISS
(mailing address)

WELL LOCATION:
sec. 12 T. 6 N. R. 16 E.
S W
4 miles South of Caesar
(distance) (direction) (nearest town)

WELL PURPOSE: Home
(home, irrigation, municipal, industrial)

WELL COMPLETION DATA:

(1) diameter (inches) 2
(2) total depth (feet) 555
(3) static water level (feet) 21 below top of ground.
(4) casing Galv 535 (material) (depth)
2 (size) If telescope see back.
(5) screen 10' 535 (length) (depth to top)
012 2" S. steel (size) (material)
(6) pump 1/2 14 (HP) (yield gpm)
Elec (type power)
(7) electric log NO (yes or no)
(organization running log)
(8) how well bottom plugged B.W. Valve

description of fomations encountered	from	to
Surface Clay	0	20
Sand	20	78
White Clay	78	90
Blue Clay	90	227
Sand	227	240
Blue Clay	240	510
Grey Sand	510	555


CODED

SEP 15 1970

DRILLERS REMARKS: MISS. BD. OF WATER COMM

If well telescopes please sketch and show depths.

GROUND LEVEL

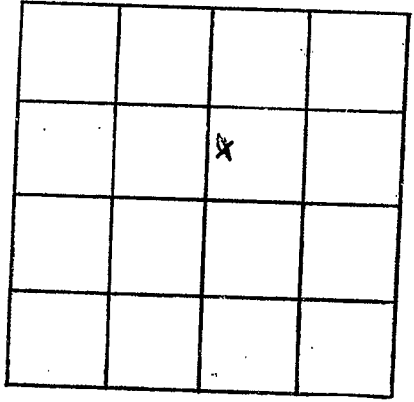

SECTION 12

Please indicate well location X.

ADDITIONAL INFORMATION

Lined area for additional information.

If more than one screen, show locations of each on sketch.