

PEARL RIVER

X 21

8-24-70

MISSISSIPPI BOARD OF WATER COMMISSIONERS
416 North State Street
Jackson, Mississippi 39201

CODED

WATER WELL DRILLERS LOG

8-24

1970 Penton Well serv

Pearl River

date well completed

firm name

county well located

LANDOWNER: Harry Mitchell

Rt. 2 Box 1960

Ponchatoula La -
(mailing address)

description of fomations encountered

from

to

Surface clay

0 20

Sand

20 90

Blue Clay

90 165

Grey Sand

165 185

WELL LOCATION:

sec. 8 T. 6 S. R. 16

1 1/2 miles East of Picayune
(distance) (direction) (nearest town)

WELL PURPOSE: Home

(home, irrigation, municipal, industrial)

WELL COMPLETION DATA:

(1) diameter (inches) 2

(2) total depth (feet) 185

(3) static water level (feet) 31 below
top of ground. above

(4) casing Galv, 180
(material) (depth)

2
(size) if telescope see back.

(5) screen 5, 180
(length) (depth to top)

2, PVC
(size) (material)

(6) pump 1/2, 9
(HP) (yield gpm)

Elec
(type power)

(7) electric log NO
(yes or no)

(organization running log)

(8) how well bottom plugged B.W. Value


DRILLERS REMARKS:

SEP 15 1970

MISS. BD. OF
WATER COMM.

If well telescopes please sketch and show depths.

GROUND LEVEL

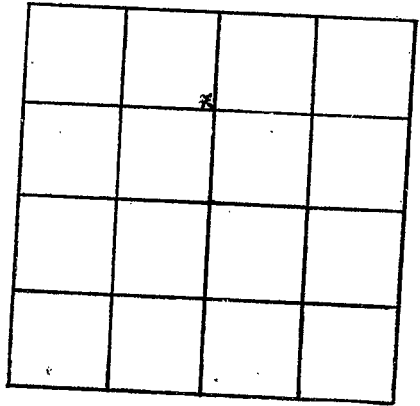

SECTION 8

Please indicate well location X.

ADDITIONAL INFORMATION

If more than one screen,
show locations of each on sketch.