

Pearl River
 222
 5-23-70

MISSISSIPPI
 BOARD OF WATER COMMISSIONERS
 416 North State Street
 Jackson, Mississippi 39201

CODED

WATER WELL DRILLERS LOG

5-26 1970 Ed J. Quarterwell Serv. Co. Pearl River County

LANDOWNER:

Virgil Skipper
 R.F. 3 Pigeonville, MS.
 (mailing address)

description of formations encountered

	from	to
red clay	0	16
Fine white silt	16	26
Co. Red & W. sd.	26	38
white clay	38	48
Blue clay	48	132
med. Red sd.	132	140
Blue clay	140	528
Fine Blue sd.	528	535
Blue clay	535	550
Fine Blue sd.	550	571
Blue Shale	571	600
Co. Gray sd.	600	627

WELL LOCATION:

sec. 12 T. 6 N. R. 16 E.
 4 miles NE of Pigeonville
 (distance) (direction) (nearest town)

WELL PURPOSE:

Home (home, irrigation, municipal, industrial)

WELL COMPLETION DATA:

- (1) diameter (inches) 4.5
- (2) total depth (feet) 627
- (3) static water level (feet) 6 below above top of ground.
- (4) casing Galv. (material) 617 (depth)
 (size) if telescope see back.
- (5) screen 10 (length) 617-627 (depth to top)
2" (size) 55 (material)
- (6) pump 3/4 (HP) 700 Perfor. (yield gpm)
Elect (type power)
- (7) electric log NO (yes or no)
 (organization running log)
- (8) how well bottom plugged Shoe

CODED


JUL 26 1970

DRILLERS REMARKS:

MISS. BD. OF
 WATER COMMISSIONERS

If well telescopes please sketch and show depths.

GROUND LEVEL

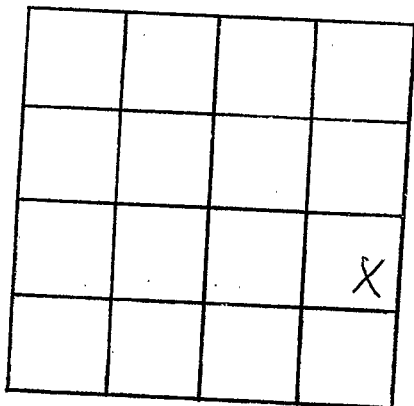

SECTION 12

Please indicate well location X.

ADDITIONAL INFORMATION

If more than one screen,
show locations of each on sketch.