

Pearl River  
X 23  
5-26-70

MISSISSIPPI  
BOARD OF WATER COMMISSIONERS  
416 North State Street  
Jackson, Mississippi 39201

**CODED**

WATER WELL DRILLERS LOG

5-26 1970 E. J. Winter Well Serv. Pearl River  
date well completed firm name county well located

LANDOWNER:	description of formations encountered	from	to
Herman Mitchell			
Rt. 3 Pigeonville Miss. (mailing address)	white Co. sd.	13	42
WELL LOCATION: sec. 12 T. 6 N. R. 16 E. 4 miles NE of Pigeonville (distance) (direction) (nearest town)	Blue clay	42	171
	Fine Gray sd.	171	200
WELL PURPOSE: Home (home, irrigation, municipal, industrial)	Coarse Gray sd.	200	212
WELL COMPLETION DATA:			
(1) diameter (inches) 4.5			
(2) total depth (feet) 212			
(3) static water level (feet) 22 below top of ground			
(4) casing Galv. 20.7 (material) (depth)			
(size) if telescope see back.			
(5) screen 5 207-12 (length) (depth to top)			
2" S.S. (size) (material)			
(6) pump Did not sell pump. (HP) (yield gpm)			
Elect (type power)			
(7) electric log NO (yes or no)			
(organization running log)			
(8) how well bottom plugged shoe			
DRILLERS REMARKS:			


**CODED**

JUL 28 1970

MISS. Bd. OF  
WATER COMM.

If well telescopes please sketch and show depths.

GROUND LEVEL

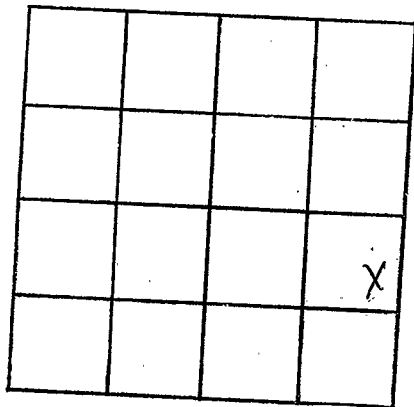

SECTION 72

Please indicate well location X.

ADDITIONAL INFORMATION

If more than one screen, show locations of each on sketch.