

Pearl River
X 24
5-27-70

MISSISSIPPI
BOARD OF WATER COMMISSIONERS
416 North State Street
Jackson, Mississippi 39201

CODED

WATER WELL DRILLERS LOG

5-27 1970 B & J water well serv. Pearl River
date well completed firm name county well located

LANDOWNER:
Reith S.K. Plev

Rt. 3 Piquette Ave. Miss.
(mailing address)

WELL LOCATION:
sec. 14 T 6 N R 16 E
(distance) miles (direction) of (nearest town)

description of formations encountered	from	to
<u>Red clay</u>	<u>0</u>	<u>15</u>
<u>white sd. & gravel</u>	<u>15</u>	<u>53</u>
<u>white clay</u>	<u>53</u>	<u>66</u>
<u>Blue clay</u>	<u>66</u>	<u>82</u>
<u>Fine Red sd.</u>	<u>82</u>	<u>128</u>
<u>Blue clay</u>	<u>128</u>	<u>222</u>
<u>Coarse Gray sd.</u>	<u>222</u>	<u>248</u>

WELL PURPOSE:
(home, irrigation, municipal, industrial)

WELL COMPLETION DATA:

(1) diameter (inches) 4 1/2

(2) total depth (feet) 248

(3) static water level (feet) 48 below above top of ground.

(4) casing Cob. 243
(material) (depth)
_____ if telescope see back.
(size)

(5) screen 5' 248-8
(length) (depth to top)
2 5.5
(size) (material)

(6) pump 1/2 400 Per
(HP) (yield gpm) Hpr
Elect
(type power)

(7) electric log NO
(yes or no)

(organization running log)

(8) how well bottom plugged _____

CODED


JUL 28 1970

DRILLERS REMARKS:

MISS. BD. OF
WATER COMMISSIONERS

If well telescopes please sketch and show depths.

GROUND LEVEL

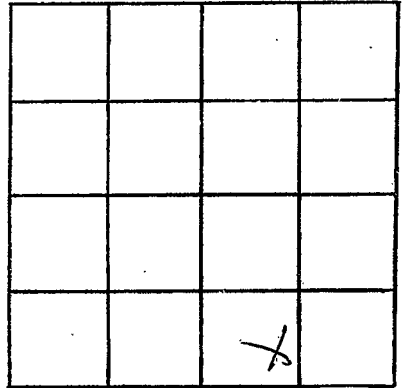

SECTION 14

Please indicate well location X.

ADDITIONAL INFORMATION

If more than one screen, show locations of each on sketch.