

LeLux

PEARL RIVER
X 25
9-7-70

MISSISSIPPI
BOARD OF WATER COMMISSIONERS
416 North State Street
Jackson, Mississippi 39201

CODED

WATER WELL DRILLERS LOG

9-7 1970 Panton Well Serv Pearl River
date well completed firm name county well located

LANDOWNER: Michael T. LeLux
600 2nd St
Picayune Miss.
(mailing address)

WELL LOCATION:
sec. 6 T. 6 S. R. 16 W.
0 miles N.E. of Picayune
(distance) (direction) (nearest town)

WELL PURPOSE: Home
(home, irrigation, municipal, industrial)

- WELL COMPLETION DATA:
- (1) diameter (inches) 2"
 - (2) total depth (feet) 990
 - (3) static water level (feet) Flow ^{below} above top of ground.
 - (4) casing Black, 970,
(material) (depth)
2 if telescope see back.
(size)
 - (5) screen 20', 970
(length) (depth to top)
2", S. steel
(size) (material)
 - (6) pump _____
(HP) (yield gpm)
(type power)
 - (7) electric log NO
(yes or no)
(organization running log)
 - (8) how well bottom plugged B.W. LeLux

description of formations encountered	from	to
Surface Clay	0	20
Sand	20	38
White Clay	38	90
Blue Clay	90	180
Grey Sand	180	238
Blue Clay	238	330
Grey Sand	330	422
Blue Clay	422	696
Grey Sand	696	830
Blue Clay	830	940
Grey Sand	940	970

CODED

015


OCT 9 1970

DRILLERS REMARKS:

MISS. BD. OF
WATER COMM.

If well telescopes please sketch and show depths.

GROUND LEVEL

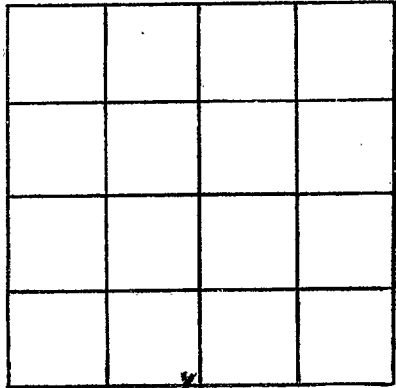

SECTION ~~12~~ 6

Please indicate well location X.

ADDITIONAL INFORMATION

If more than one screen, show locations of each on sketch.