

PEARL RIVER  
 X 26  
 7-13-70

MISSISSIPPI  
 BOARD OF WATER COMMISSIONERS  
 416 North State Street  
 Jackson, Mississippi 39201

**CODED**

WATER WELL DRILLERS LOG

7-13 1970 Pantone Well Serv Pearl River  
 date well completed firm name county well located

LANDOWNER: John K. Aines  
 Rt. 3  
 Piquette Miss  
 (mailing address)

description of formations encountered	from	to
Surface Clay	0	30
Red Clay	30	58
Mud	58	110
yellow Clay	110	120
Blue Clay	120	145
Grey Sand	175	193

WELL LOCATION:  
 sec. 4 T. 6 N. R. 16 E.  
 3 miles East of Piquette  
 (distance) (direction) (nearest town)

WELL PURPOSE: Home  
 (home, irrigation, municipal, industrial)

- WELL COMPLETION DATA:
- (1) diameter (inches) 2
  - (2) total depth (feet) 193
  - (3) static water level (feet) 30 below above top of ground.
  - (4) casing Galv 188 (material) (depth)
  - 2" If telescope see back. (size)
  - (5) screen 5' 188 (length) (depth to top)
  - 012 2 S. Steel (size) (material)
  - (6) pump 1/2 (HP) (yield gpm)
  - Elec (type power)
  - (7) electric log NO (yes or no)
  - (organization running log)
  - (8) how well bottom plugged BU Valve

**CODED**


AUG 6 1970

DRILLERS REMARKS:

MISS. DEPT. OF  
 WATER COMMISSIONERS

If well telescopes please sketch and show depths.

GROUND LEVEL

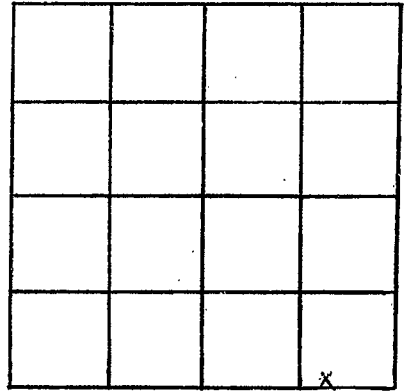

SECTION 4

Please indicate well location X.

ADDITIONAL INFORMATION

If more than one screen,  
show locations of each on sketch.