

PEARL RIVER

X 27

10-8-70

MISSISSIPPI BOARD OF WATER COMMISSIONERS
416 North State Street
Jackson, Mississippi 39201

CODED

WATER WELL DRILLERS LOG

NEIL LUMPKIN WELL DRILLING SERVICE
P. O. BOX 117

10-8-70
date well completed

1970

PEARL RIVER, MISS.
firm name

Pearl River
county well located

LANDOWNER: Foster R. Smith

Description of formations encountered

from

to

Picayune, Miss.
Route 3, Box 382
(mailing address)

Surface Clay

0 20

sand

20 80

WELL LOCATION:

sec. 10 T. 6 S. R. 16
7 miles East of Picayune
(distance) (direction) (nearest town)

white + blue clay

80 180

good white sand

180 250

WELL PURPOSE: home
(home, irrigation, municipal, industrial)

blue clay + shale

250 570

WELL COMPLETION DATA:

good grey sand

570 636

(1) diameter (inches) 2"

(2) total depth (feet) 636

(3) static water level (feet) 22 below above top of ground.

(4) casing galv. 630'
(material) (depth)

2" if telescope see back.
(size)

(5) screen 5'
(length) (depth to top)

2' S. Steel
(size) (material)

(6) pump 1 5.50 gpm
(HP) (yield gpm)

electric
(type power)

(7) electric log no.
(yes or no)

(organization running log)

(8) how well bottom plugged Johnson

B.P. Zahra

DRILLERS REMARKS:


CODED

NOV 3 - 1970

MISC. NO. OR
WATER CODE

If well telescopes please sketch and show depths.

GROUND LEVEL

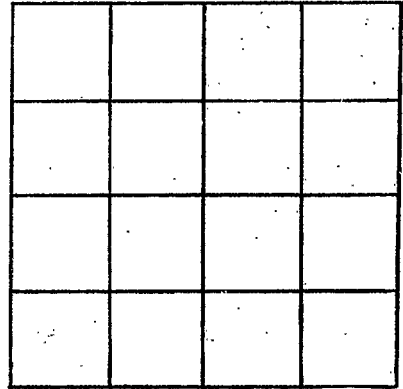

SECTION _____

Please indicate well location X:

ADDITIONAL INFORMATION

Lined area for providing additional information.

If more than one screen, show locations of each on sketch.