

PEARL RIVER

X 28

10-3-70

MISSISSIPPI BOARD OF WATER COMMISSIONERS
416 North State Street
Jackson, Mississippi 39201

CODED

WATER WELL DRILLERS LOG

10-3

19

70 Lanton Well Serv Pearl River

date well completed

firm name

county well located

LANDOWNER: Mrs Edna Wilson

Rt 1. Box 202

Picayune MISS
(mailing address)

WELL LOCATION:

sec. 21 T. 6 N R. 16 E
S W
3 miles East of Picayune
(distance) (direction) (nearest town)

WELL PURPOSE:

Home
(home, irrigation, municipal, industrial)

WELL COMPLETION DATA:

- (1) diameter (inches) 2
- (2) total depth (feet) 1020
- (3) static water level (feet) flow below above top of ground.
- (4) casing Black, 1000
(material) (depth)
2 if telescope see back.
(size)
- (5) screen 20', 1000
(length) (depth to top)
2", S. Steel
(size) (material)
- (6) pump ✓ (HP) ✓ (yield gpm)
(type power)
- (7) electric log NO
(yes or no)
(organization running log)
- (8) how well bottom plugged Blw. Valve

description of formations encountered

from to

Surface Clay	0	22
Red sand	22	58
White clay	58	70
Blue Clay	70	285
Mud	285	310
Blue clay	310	338
Sand	338	358
Blue Clay	358	570
Grey sand	570	750
Blue clay	750	950
Grey sand	950	1020

CODED


NOV 10 1970

DRILLERS REMARKS: 7 lbs at ground level

MISSISSIPPI BOARD OF WATER COMMISSIONERS

If well telescopes please sketch and show depths.

GROUND LEVEL

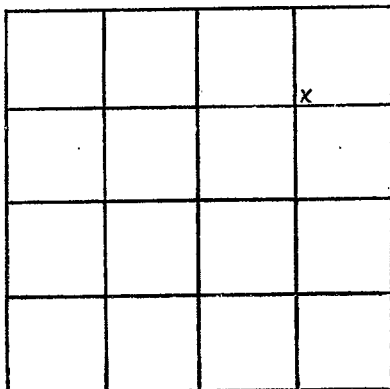

SECTION 21

Please indicate well location X.

ADDITIONAL INFORMATION

If more than one screen,
show locations of each on sketch.