

PEARL RIVER  
X 31  
2-13-71

MISSISSIPPI  
BOARD OF WATER COMMISSIONERS  
416 North State Street  
Jackson, Mississippi 39201

**CODED**

WATER WELL DRILLERS LOG

2-13 1971 Penton Well Serv Pearl River  
date well completed firm name county well located

LANDOWNER: Ernest Cochran  
821 Caffin Ave  
New Orleans La 70117  
(mailing address)

description of formations encountered	from	to
Surface Clay	0	27
Sand	27	58
White Clay	58	75
Blue Clay	75	220
Sand	220	256

WELL LOCATION:  
sec. 10 T. 6 N R. 16 W  
S W  
3 miles East of Picayune  
(distance) (direction) (nearest town)

WELL PURPOSE: Home  
(home, irrigation, municipal, industrial)

WELL COMPLETION DATA: 4 1/2

(1) diameter (inches) 2

(2) total depth (feet) 256

(3) static water level (feet) 27 below ~~ground~~  
top of ground. 27

(4) casing Galv, 251,  
(material) (depth)

2 if telescope see back.  
(size)

(5) screen 5', 251  
(length) (depth to top)

2, S. Steel  
(size) (material)

(6) pump 1/2  
(HP) (yield gpm)

Elec  
(type power)

(7) electric log NO  
(yes or no)

(organization running log)

**CODED**

(8) how well bottom plugged BW. Valve


MAR 9 1971

DRILLERS REMARKS:

MISS. BD. OF  
WATER COMM.

If well telescopes please sketch and show depths.

GROUND LEVEL

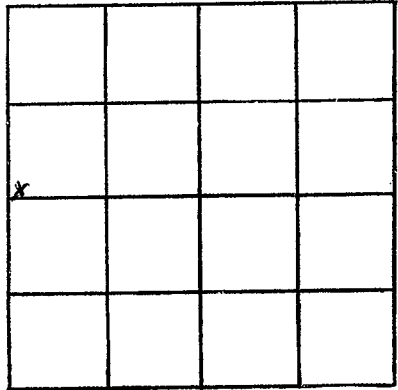

SECTION 10

Please indicate well location X.

ADDITIONAL INFORMATION

If more than one screen, show locations of each on sketch.