

PEARL RIVER
X 32
4-3-71

MISSISSIPPI
BOARD OF WATER COMMISSIONERS
416 North State Street
Jackson, Mississippi 39201

CODED

WATER WELL DRILLERS LOG

Pearl River
~~Stanton~~

4-3
date well completed

1971 Stanton Well Serv
firm name

county well located

LANDOWNER: Edward Doubert

description of formations encountered	from	to
	Surface clay	0
Red sand	38	65
White clay	65	88
Blue clay	88	196
Sand	196	221

Rt. 2

Picayune Miss.
(mailing address)

WELL LOCATION:
sec. 1 T. 6 S. R. 16 W.
3 miles South of Caesar
(distance) (direction) (nearest town)

WELL PURPOSE: Home
(home, irrigation, municipal, industrial)

WELL COMPLETION DATA:

- (1) diameter (inches) 2
- (2) total depth (feet) 221
- (3) static water level (feet) 55 below top of ground.
- (4) casing Galv. 216 (material) (depth)
- (size) 2 if telescope see back.
- (5) screen 5' 216 (length) (depth to top)
- (size) 2 S. Steel (material)
- (6) pump 1 10 (HP) (yield gpm)
- (type power) Elec
- (7) electric log NO (yes or no)
- (organization running log)
- (8) how well bottom plugged BW Valve

CODED


MAY 2 - 1971

MISS. Bd. of WATER COMMISSIONERS

DRILLERS REMARKS:

If well telescopes please sketch and show depths.

GROUND LEVEL

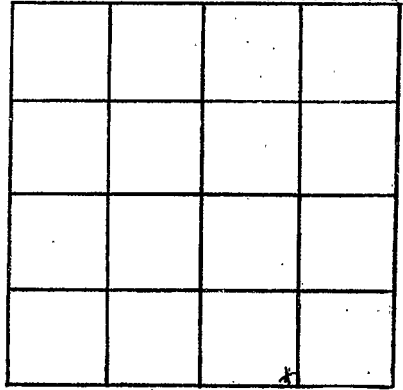

SECTION 1

Please indicate well location X.

ADDITIONAL INFORMATION

If more than one screen, show locations of each on sketch.