

PEARL RIVER
X 33
5-11-71

MISSISSIPPI
BOARD OF WATER COMMISSIONERS
416 North State Street
Jackson, Mississippi 39201

CODED

WATER WELL DRILLERS LOG

5-11 date well completed 19 71 Penton Well Serv firm name Pearl River county well located

LANDOWNER: Mason Penton
Rt. 3
Picayune Miss
(mailing address)

description of formations encountered	from	to
Surface clay	0	28
Sand	28	48
White clay	48	72
Blue clay	72	180
Fine sand	180	185
Blue clay	185	530
Grey sand	530	609

WELL LOCATION:
sec. 9 T 6 S R 16 E
3 miles East of Picayune
(distance) (direction) (nearest town)

WELL PURPOSE: Home
(home, irrigation, municipal, industrial)

- WELL COMPLETION DATA:
- (1) diameter (inches) 2
 - (2) total depth (feet) 609
 - (3) static water level (feet) 8 below top of ground.
 - (4) casing Galv. (599)
(material) (depth)
2 if telescope see back.
(size)
 - (5) screen 10 (599)
(length) (depth to top)
2 (Stainless Steel)
(size) (material)
 - (6) pump 1/2 (10)
(HP) (yield gpm.)
Elec
(type power)
 - (7) electric log No
(yes or no)
 - (organization running log)
 - (8) how well bottom plugged Bar Valve

CODED


JUN 16 1971

DRILLERS REMARKS:

MISS. BD. OF
WATER COMMISSIONERS

If well telescopes please sketch and show depths.

GROUND LEVEL

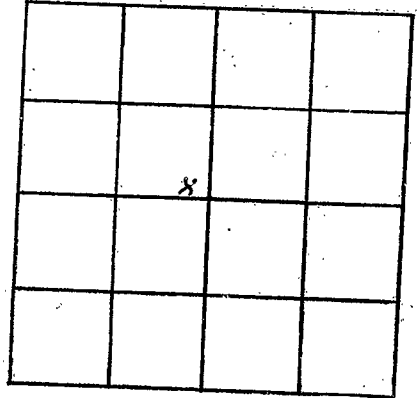

SECTION _____

Please indicate well location X.

ADDITIONAL INFORMATION

If more than one screen, show locations of each on sketch.