

PEARL RIVER
 X 35
 6-12-71

MISSISSIPPI
 BOARD OF WATER COMMISSIONERS
 416 North State Street
 Jackson, Mississippi 39201

CODED

WATER WELL DRILLERS LOG

6-12
 date well completed

1971 Bud Center & Son
 firm name

Pearl River
 county well located

LANDOWNER:	description of formations encountered	from	to
Robert Williams (mailing address)			
	White Sand	14	74
	Blue Shale	74	186
	Blue Sand	186	262
WELL LOCATION:			
sec. 18 T. 6 N. R. 16 E. S. 5			
1.2 miles E of Lumberton			
WELL PURPOSE: Domestic (home, irrigation, municipal, industrial)			
WELL COMPLETION DATA:			
(1) diameter (inches) 2 1/2			
(2) total depth (feet) 262			
(3) static water level (feet) 24 below top of ground.			
(4) casing Galv. 251 (material) (depth)			
(size) if telescope see back.			
(5) screen 2x5, 251 (length) (depth to top)			
2x5, 8' (size) (material)			
(6) pump 1/2 (HP) 250 (yield gpm)			
electric (type power)			
(7) electric log NO (yes or no)			
(organization running log)			
(8) how well bottom plugged			
DRILLERS REMARKS:			
JUL 8 1971			
MISS. BD. OF WATER COMM.			


CODED

If well telescopes please sketch and show depths.

Handwritten notes at the top of the page, possibly including a date or location.

GROUND LEVEL

Handwritten notes in the left column, possibly describing well components or observations.

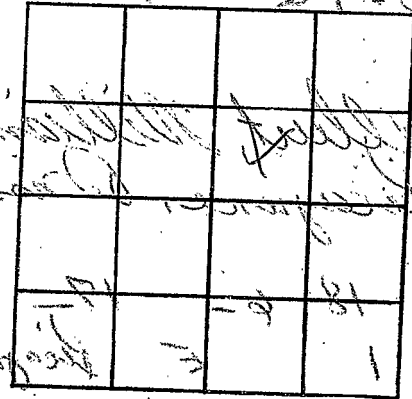

Handwritten word, possibly 'small'.

SECTION _____

Please indicate well location X.

ADDITIONAL INFORMATION

Multiple lines of handwritten notes under the 'ADDITIONAL INFORMATION' section, providing further details about the well.

If more than one screen, show locations of each on sketch.