

PEARL RIVER
X 36
7-8-71

MISSISSIPPI
BOARD OF WATER COMMISSIONERS
416 North State Street
Jackson, Mississippi 39201

CODED

WATER WELL DRILLERS LOG

7-8 1971 Penton Well Serv Pearl River
date well completed firm name county well located

LANDOWNER: H. K. Stockstill
Rt. 2 Box 99A
Carriere Miss.
(mailing address)

description of formations encountered	from	to
Surface Clay	0	18
Sand	18	45
White Clay	45	90
Blue Clay	90	185
SAND	185	210

WELL LOCATION:
sec. 6 T. 6 S. R. 16 W.
1 miles NE of Picayune
(distance) (direction) (nearest town)

WELL PURPOSE: Home
(home, irrigation, municipal, industrial)

- WELL COMPLETION DATA:
- (1) diameter (inches) 2
 - (2) total depth (feet) 210
 - (3) static water level (feet) 45 below top of ground.
 - (4) casing Galv., 205,
(material) (depth)
2 If telescope see back.
(size)
 - (5) screen 5, 205
(length) (depth to top)
2, S. Steel
(size) (material)
 - (6) pump 1, 12
(HP) (yield gpm)
(type power)
 - (7) electric log NO
(yes or no)
(organization running log)
 - (8) how well bottom plugged B.W. Valve

CODED


JUL 23 1971

MISS. BD. OF
WATER COMM.

DRILLERS REMARKS:

If well telescopes please sketch and show depths.

GROUND LEVEL

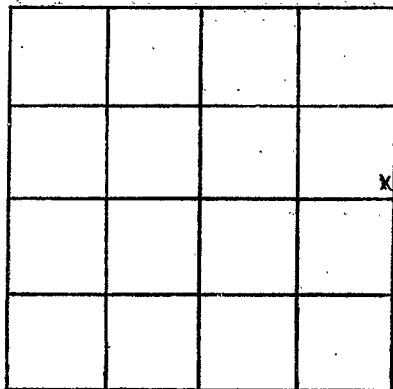

SECTION 6

Please indicate well location X.

ADDITIONAL INFORMATION

If more than one screen, show locations of each on sketch.