

PEARL RIVER  
X 37  
7-13-71

MISSISSIPPI  
 BOARD OF WATER COMMISSIONERS  
 416 North State Street  
 Jackson, Mississippi 39201

**CODED**

WATER WELL DRILLERS LOG

7-13  
 date well completed

1971 Penitok Well Serv  
 firm name

Pearl River  
 county well located

LANDOWNER: Edgar Mclemore  
Rt. 3  
Picayune Miss  
 (mailing address)

description of formations encountered	from	to
	Surface Clay	0
Sand	23	55
Red Clay	55	70
Sand	70	125
Blue Clay	125	200
Sand	200	230

WELL LOCATION:  
 sec. 4 T. 6 N. R. 16 W.  
S W  
4 miles East of Picayune  
 (distance) (direction) (nearest town)

WELL PURPOSE: Home  
 (home, irrigation, municipal, industrial)

- WELL COMPLETION DATA:
- (1) diameter (inches) 2"
  - (2) total depth (feet) 230
  - (3) static water level (feet) 31 below top of ground.
  - (4) casing Galv., 225,  
 (material) (depth)  
2 If telescope see back.  
 (size)
  - (5) screen 5', 225  
 (length) (depth to top)  
2, St. Steel  
 (size) (material)
  - (6) pump 1, 11  
 (HP) (yield gpm)  
Elec  
 (type power)
  - (7) electric log No  
 (yes or no)  
 (organization running log)
  - (8) how well bottom plugged B.W. Value

**CODED**


JUL 22 1971

DRILLERS REMARKS:

MISS. BD. OF  
 WATER COM.

If well telescopes please sketch and show depths.

GROUND LEVEL

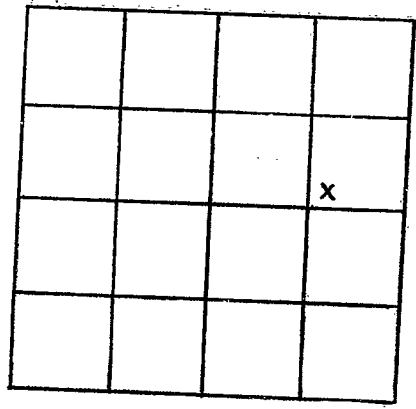

SECTION 4

Please indicate well location X.

ADDITIONAL INFORMATION

Lined area for additional information.

If more than one screen, show locations of each on sketch.