

Pearl River
X 38
7-27-71

MISSISSIPPI
 BOARD OF WATER COMMISSIONERS
 416 North State Street
 Jackson, Mississippi 39201

CODED

WATER WELL DRILLERS LOG

7-27 date well completed 1971 Penton Well Serv Pearl River firm name county well located

LANDOWNER: Archie McQueen
Nicholson Miss
 (mailing address)

description of formations encountered	from	to
Surface Clay	0	26
Sand	26	55
White Clay	55	95
Mud	95	105
Blue Clay	105	275
Sand	275	306

WELL LOCATION:
 sec. 16 T. 6 S. R. 16 W.
3 miles East of Picayune
 (distance) (direction) (nearest town)

WELL PURPOSE: Home
 (home, irrigation, municipal, industrial)

- WELL COMPLETION DATA:
- (1) diameter (inches) 2
 - (2) total depth (feet) 306
 - (3) static water level (feet) 42 below top of ground.
 - (4) casing Galv, 301
 (material) (depth)
2 if telescope see back.
 (size)
 - (5) screen 5', 301
 (length) (depth to top)
2, S. Steel
 (size) (material)
 - (6) pump 1 (HP) (yield gpm)
Elec
 (type power)
 - (7) electric log NO
 (yes or no)
 (organization running log)
 - (8) how well bottom plugged Br. Valve

CODED


DRILLERS REMARKS:

AUG 3 - 1971

MISS. RD. OF
 WATER COMMISSIONERS

If well telescopes please
sketch and show depths.

GROUND LEVEL

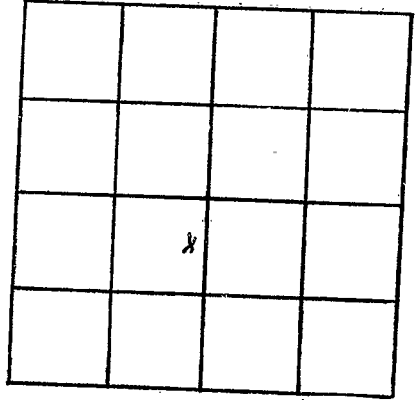

SECTION 16

Please indicate well location X.

ADDITIONAL INFORMATION

If more than one screen,
show locations of each on sketch.