

CODED

WATER WELL DRILLERS LOG

OX-39
5-22-62

Date: 5-22, 1962, Driller: Quick & Ginn County P.R.
370-4 (Name)

(1) Owner of Land: Jake Stuchlik
(Name)
Picayune, Miss.
(Address)

(2) Location: 1/4, 1/4, Sec. 8 T6 R16
4 miles north of Picayune
(distance) (direction) (Nearest Town)

(3) Topography: (Hilly) (Flat) (Level)

(4) Purpose of Well: Domestic
(Domestic Irrigation, Municipal, Industrial, Other)

Description & Color of Materials Sand, Clay, Red Clay, Shell, etc.	Thick- ness Feet	Depth Feet
<u>red clay</u>	<u>0</u>	<u>25</u>
<u>sand + gravel</u>	<u>25</u>	<u>50</u>
<u>blue clay</u>	<u>50</u>	<u>145</u>
<u>gray sand</u>	<u>745</u>	<u>195</u>
<u>blue clay</u>	<u>775</u>	<u>315</u>
<u>gray sand</u>	<u>315</u>	<u>365</u>
<u>blue clay</u>	<u>365</u>	<u>500</u>
<u>gray sand</u>	<u>500</u>	<u>555</u>
<u>blue clay</u>	<u>555</u>	<u>715</u>
<u>gray sand</u>	<u>715</u>	<u>785</u>
<u>blue clay</u>	<u>785</u>	<u>925</u>
<u>good gray sand</u>	<u>925</u>	<u>1028</u>

Information upon completion of well:

(1) Diameter 2" inches.

(2) Total Depth 1028 feet.

(3) Water Level flowing feet below top of ground.

(4) Cased to _____, Size _____

(5) Screen: Size 2", Length 10'

(6) Were any formations sealed against pollution?
_____ yes, no.


If YES depth of formation _____

Why _____

Drillers Remarks: _____

CODED

1028

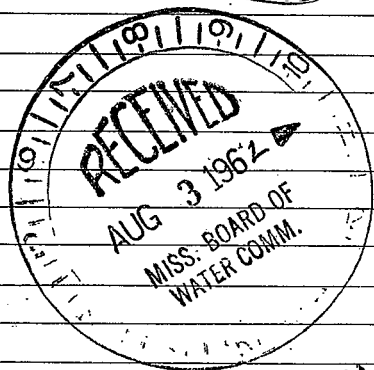

100

Well No.

(Use Back Side)

