

X-40
5-22-62

WATER WELL DRILLERS LOG

CODED

Date: May 22 1962 Driller: MCS Drilling Co. County: Clarke
379-24 (Name)

(1) Owner of Land: Mr. Lake
(Name)

6 mile East Piquette on
Kila-Piquette Road
(Address)

(2) Location: 1/4, 1/4, Sec. 11 T. 6R16,
ON Piquette-Kila Rd.
6 miles East, of Piquette
(distance) (direction) (Nearest Town)

(3) Topography: Level
(Hilly) (Flat) (Level)

(4) Purpose of Well: Stock well
(Domestic Irrigation
Municipal, Industrial, Other)

Description & Color of Materials Sand, Clay, Red Clay, Shell, etc.	Thick- ness Feet	Depth Feet
Clay	8	8
Sand	37	45
White Clay	35	80
Blue Clay	30	110
Sand	15	125
Blue Clay	15	140
Blue White Red Clay	50	190
Blue Clay	85	275
Fine Grey Sand	20	295
Sand & Clay Breaks	13	308
Sand (Fine Grey)	16	324
Blue Clay	76	400
Sand (Clay)	60	460
Blue Clay		

Information upon completion of well:

(1) Diameter 2 inches.

(2) Total Depth 458 feet.

(3) Water Level 10 feet below top of ground.

(4) Cased to 452, Size 2"

(5) Screen: Size 2" R. & L., Length 6 FT.


(6) Were any formations sealed against pollution?
_____ yes, _____ no.

If YES depth of formation _____

Why _____

Drillers Remarks: _____

CODED

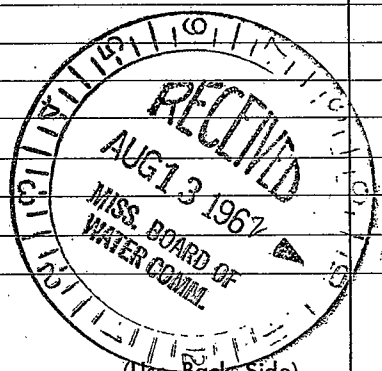

(Use Back Side)

