

Pearl R.

Date: 6/30, 1962, Driller: POUPART

County Pearl River

6-30-62 Lyde DANIELS
(1) Owner of Land: DANIELS
(Name)

Route
(Address)

(2) Location: 1/4, 1/4, Sec. 4 T6 R16,

5 miles N.E. of PLYMOUTH
(distance) (direction) (Nearest Town)

(3) Topography: (Hilly) (Flat) (Level)

(4) Purpose of Well: Home use
(Domestic Irrigation, Municipal, Industrial, Other)

Information upon completion of well:

(1) Diameter 2" inches.

(2) Total Depth 600 feet.

(3) Water Level 9" feet below top of ground.

(4) Cased to _____, Size _____

(5) Screen: Size 8 gauge Length 10'

(6) Were any formations sealed against pollution?

_____ yes, _____ no.

If YES depth of formation _____

Why _____


Drillers Remarks: _____

Description & Color of Material
Sand, Clay, Red Clay, Shell, etc.

Depth
Feet

Description & Color of Material	Depth Feet
Brown SAND	0
Red Clay.	6 10
SAND	20 30
Clay + SAND BREAKS	70 150
WHITE SAND	18 178
BLUE CLAY	372 550
PINE SAND	25 575
B CLAY	10 585
BLUE CLAY	600
Coarse Sand	600

CODED

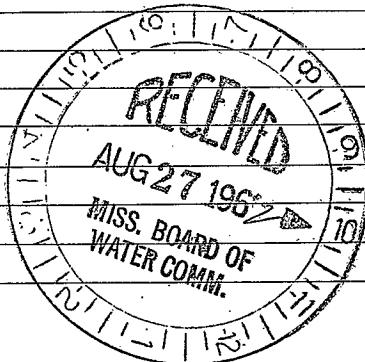

(Use Back Side)

Well No.

