

Pearl R.

WATER WELL DRILLERS LOG

X-42

Date: 5/16, 1963, Driller: POUPART

PEARL RIVER
COUNTY

5-16-63 384-13

CODED

(1) Owner of Land: LEONARD WAGES
(Name)

Rt 2 PICAYUNE MISS
(Address)

(2) Location: 1/4, 1/4, Sec. 15 T6 R16
6 miles EAST of PICAYUNE
(distance) (direction) (Nearest Town)

(3) Topography: (Hilly) (Flat) (Level)

(4) Purpose of Well: DOMESTIC
(Domestic Irrigation, Municipal, Industrial, Other)

Description & Color of Material
Sand, Clay, Red Clay, Shell, etc.

Thickness
Feet

Depth
Feet

SAND	20	
SAND GRAVEL	60	80
Clay	30	120
SAND	40	160
Blue Clay	60	220
" "	60	280
GREY SAND	40	320
Clay	80	400
" "	80	480
SAND	120	620
Clay	80	700
SAND	90	780
Clay	60	840
SAND		970

Information upon completion of well:

(1) Diameter 2 inches.

(2) Total Depth 970 feet.

(3) Water Level FLOW feet below top of ground.

(4) Cased to _____, Size _____

(5) Screen: Size 2/10, Length 30'


(6) Were any formations sealed against pollution?
_____ yes, _____ no.

If YES depth of formation _____

Why _____

Drillers Remarks: _____

CODED

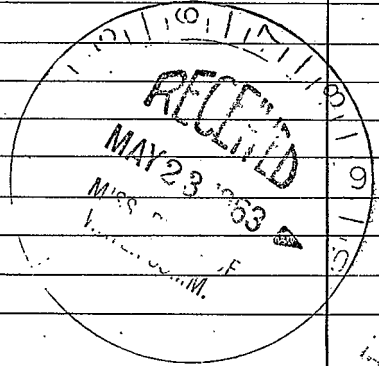

(Use Back Side)

Well No.

