

WELL DRILLERS LOG

Pearl R. X-43 W
8-63 PEARL
County RIVER

Driller: POUPART
579-18 32 356 1/8 (Name)

(1) Owner of Land: OSWALD, MOLLER
(Name)
SALEM
(Address)

(2) Location: 1/4, 1/4, Sec. 10, 11 T6R16,
8 miles EAST, of PIRAYUNE
(distance) (direction) (Nearest town)

(3) Topography: L
(Hilly) (Flat) (Level)

(4) Purpose of Well: DOMESTIC
(Domestic Irrigation
Municipal, Industrial, Other)

Description & Color of Sand, Clay, Red Clay, Shale	Thickness in Feet	Depth in Feet
CODED		
SOIL RED.	20	
SAND & GRAVEL		120/140
Blue Clay		160/300
Grey Clay		25/325
Blue Clay		255/580
FINE SAND		30/610
COARSE SAND		
GREY - pebble		4/657

Information upon completion of well:

(1) Diameter 2 inches.

(2) Total Depth 657 feet.

(3) Water Level FLOW feet below top of ground.

(4) Cased to _____, Size _____


(5) Screen: Size 0/10, Length 10'

(6) Were any formations sealed against pollution?
_____ yes, no.

If YES depth of formation _____

Why _____

Drillers Remarks: _____

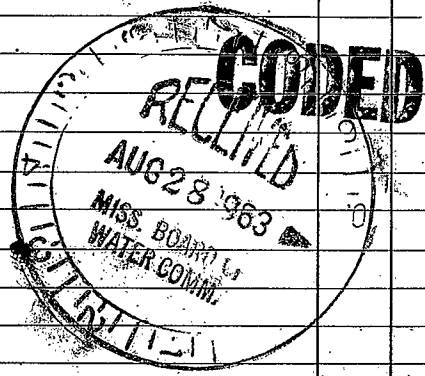

(Use Back Side)

Well No.

