

CODED

X-44
3-19-65

WATER WELL DRILLERS LOG

Date: 3-19, 1965, Driller: Walter Ponton County Pearl River
(Name)

(1) Owner of Land: S. L. Dill
(Name)
Rt. 3 Picayune Miss
(Address)

(2) Location: 1/4, 1/4, Sec. 8 65R16,
3 miles N.E. of Picayune,
(distance) (direction) (Nearest Town)

(3) Topography: Flat
(Hilly) (Flat) (Level)

(4) Purpose of Well: Domestic
(Domestic Irrigation
Municipal, Industrial, Other)

Description & Color of Materials Sand, Clay, Red Clay, Shell, etc.	Thick- ness Feet	Depth Feet
Pipe Clay	14	14
Sand & Clay	30	54
Yellow "	28	82
Blue clay	292	374
Grey Sand	16	390
Wood From 397-400		

Information upon completion of well:

(1) Diameter 2 inches.

(2) Total Depth 390 feet.

(3) Water Level 54 feet below top of ground.

(4) Cased to _____, Size _____

(5) Screen: Size 2 1/2", Length 5'


(6) Were any formations sealed against pollution?
_____ yes, ✓ no.

CODED

If YES depth of formation _____

Why _____

Drillers Remarks: _____

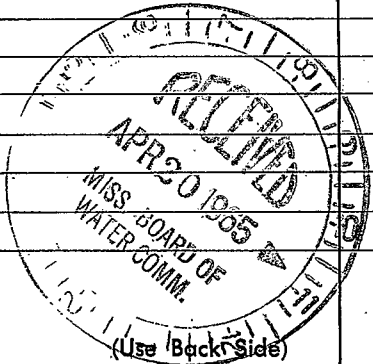

Well No.

