

X-45

7-30-65

WATER WELL DRILLERS LOG

**CODED**

Date: 7-30, 1965, Driller: Walter Ponton County Pearl River

362-38

(Name)

(1) Owner of Land: Oscar Palmer  
(Name)

Rt. 2 Carriere, Miss  
(Address)

(2) Location: 1/4, 1/4, Sec. 6 T6R16

1/2 miles NE of Poyune  
(distance) (direction) (Nearest Town)

(3) Topography: Hilly  
(Hilly) (Flat) (Level)

(4) Purpose of Well: Domestic  
(Domestic Irrigation  
Municipal, Industrial, Other)

Description & Color of Materials  
Sand, Clay, Red Clay, Shell, etc.

Thick-  
ness  
Feet

Depth  
Feet

Clay	18	0 to 18
Sand	18	36
Yellow Clay	26	62
Sandy Clay	23	85
Blue Clay	93	178
Grey Sand	90	268
Blue Clay	83	351
Grey Sand	22	383
Blue Clay	17	400
Grey Sand	28	428
Blue Clay	227	655
Grey Sand	12	667
Blue Clay	47	714
Gravel	21	735
Blue Clay	21	756
Grey Sand	54	810
Blue Clay	40	850
Grey Sand	32	882
Blue Clay	73	955
Grey Sand	31	986
Blue Clay (Hard)	4	990
Grey Sand	40	1030

Information upon completion of well:

(1) Diameter 2 inches.

(2) Total Depth 1030 feet.

(3) Water Level Flow feet below top of ground.

(4) Cased to \_\_\_\_\_, Size \_\_\_\_\_

(5) Screen: Size 010, Length 30'

(6) Were any formations sealed against pollution?


\_\_\_\_\_ yes, \_\_\_\_\_ no.

If YES depth of formation \_\_\_\_\_

Why \_\_\_\_\_

Drillers Remarks: 9 lbs. at

ground level

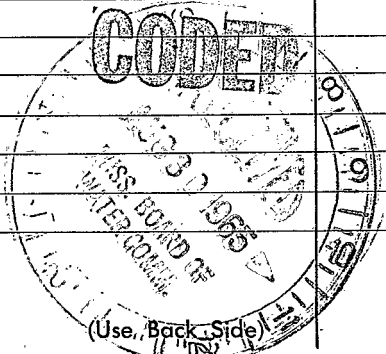

Well No.

(Use Back Side)

