

X-46
4-15-66

WATER WELL DRILLERS LOG

Date: 4/15, 1966, Driller: J. P. Poyant **CODED**
(Name)

(1) Owner of Land: Strothers
(Name)
Sycamore
(Address)
(2) Location: 1/4, 1/4, Sec. 6 T.6R.16,
3 miles East, of Picayune
(distance) (direction) (Nearest/Town)
(3) Topography: (Hilly) (Flat) (Level)
(4) Purpose of Well: Home use
(Domestic Irrigation
Municipal, Industrial, Other)


Description & Color of Materials Sand, Clay, Red Clay, Shell, etc.	Thick- ness Feet	Depth Feet
<u>Red Clay</u>	<u>0</u>	<u>20</u>
<u>Sand Gravel</u>	<u>20</u>	<u>80</u>
<u>Blue Clay</u>	<u>80</u>	<u>170</u>
<u>" Sand</u>	<u>170</u>	<u>207</u>

CODED

Information upon completion of well:

(1) Diameter 2 inches.
(2) Total Depth 207 feet.
(3) Water Level 60 feet below top of ground.
(4) Cased to 207, Size 2"
(5) Screen: Size 9/10, Length 5'
(6) Were any formations sealed against pollution?
yes, no.

If YES depth of formation _____
Why _____
Drillers Remarks: _____

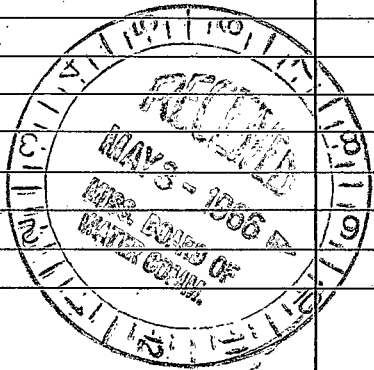

(Use Back Side)

Well No.

