

PEARL RIVER  
X 4 7  
7-9-71

MISSISSIPPI  
 BOARD OF WATER COMMISSIONERS  
 416 North State Street  
 Jackson, Mississippi 39201

WATER WELL DRILLERS LOG

7-9 19 71  
 date well completed

WELL LUMPKIN WELL DRILLING SERVICE

firm name CARRIERE MISS.

county well located

Pearl River  
**CODED**

LANDOWNER: G. H. Adcox

Carrierre, Miss.

Route 1, Box 89  
 (mailing address)

description of formations encountered

from to

Surface Clay 0 10

sand 10 80

Blue clay 80 159

Payson Mud sand 159 174

WELL LOCATION:

sec. 6 T. 6 S. R. 16 W.

1 miles NE of Payson  
 (distance) (direction) (nearest town)

WELL PURPOSE: home  
 (home, irrigation, municipal, industrial)

WELL COMPLETION DATA:

- (1) diameter (inches) 2"
- (2) total depth (feet) 174
- (3) static water level (feet) 40 below top of ground.

(4) casing galv. ~~1 1/2"~~  
 (material) (depth)  
2" if telescope see back.  
 (size)

(5) screen 5'  
 (length) (depth to top)  
2" St. Steel  
 (size) (material)

(6) pump 1/2 500 gpm  
 (HP) (yield gpm)  
electric  
 (type power)

(7) electric log no  
 (yes or no)

(organization running log)

(8) how well bottom plugged Johnson back pressure valve

DRILLERS REMARKS:


**CODED**

OCT 11 1971

MISS. BD. OF  
 WATER COMMI.

If well telescopes please  
sketch and show depths.

GROUND LEVEL

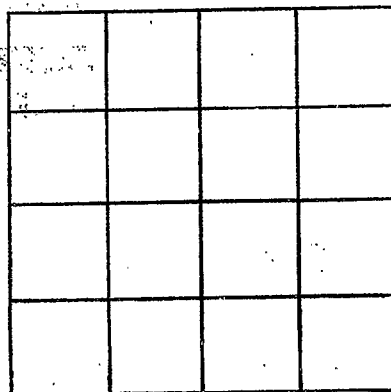

SECTION \_\_\_\_\_

Please indicate well location X.

ADDITIONAL INFORMATION

If more than one screen,  
show locations of each on sketch.