

PEARL RIVER  
X 50  
10-12-71

MISSISSIPPI  
BOARD OF WATER COMMISSIONERS  
416 North State Street  
Jackson, Mississippi 39201

**CODED**

WATER WELL DRILLERS LOG

10-12 date well completed      1971 Penton Well Serv firm name      Pearl River county well located

LANDOWNER: Jimmie Dean  
Rt. 3 Box 389  
Picayune Miss  
(mailing address)

WELL LOCATION:  
sec. 10 T 6 N R 16 W  
S W  
4 miles East of Picayune  
(distance) (direction) (nearest town)

WELL PURPOSE: Home  
(home, irrigation, municipal, industrial)

description of formations encountered	from	to
Surface Clay	0	20
Sand	20	36
White Clay	36	70
Blue Clay	70	218
Sand	218	254
Blue Clay	254	560
Fine Sand	560	680
Blue Clay	680	720
Sand	720	788
Blue Clay	788	900
Sand	900	987

WELL COMPLETION DATA:

(1) diameter (inches) 4 1/2

(2) total depth (feet) 987

(3) static water level (feet) 8 below top of ground

(4) casing Galv. 967 (material) (depth)  
4 1/2 (size) if telescope see back.

(5) screen 20 (length) 967 (depth to top)  
2" S. steel (size) (material)

(6) pump 1 (HP) 25 (yield gpm)  
Elec (type power)

(7) electric log NO (yes or no)  
(organization running log)

(8) how well bottom plugged B.W. Valve

**CODED**

NOV 9 1971


DRILLERS REMARKS:

MISS. BD. OF  
WATER COMM.

If well telescopes please sketch and show depths.

GROUND LEVEL

4" - 84'  
2" - 903

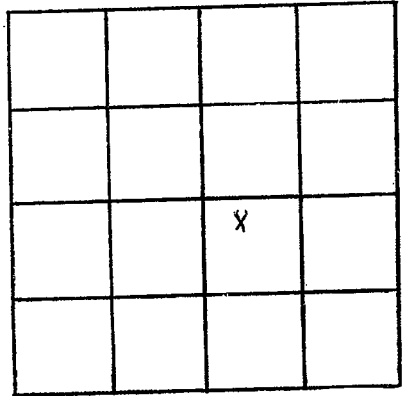

SECTION 10

Please indicate well location X.

ADDITIONAL INFORMATION

If more than one screen,  
show locations of each on sketch.