

Pearl River
X 52
11-24-71

MISSISSIPPI
 BOARD OF WATER COMMISSIONERS
 416 North State Street
 Jackson, Mississippi 39201

DEC 15 1971

WATER WELL DRILLERS LOG MISS. BD. OF

CODED

11-24-71 1971 Penton Well Serv. Pearl River
 date well completed firm name county well located

LANDOWNER: Larry Trim
512 E. Sycamore Rd.
Picayune Miss.
 (mailing address)

WELL LOCATION:
 sec 21 T 6 N R 16 E
 S W
2 1/2 miles East of Picayune
 (distance) (direction) (nearest town)

WELL PURPOSE: Home
 (home, irrigation, municipal, industrial)

- WELL COMPLETION DATA:
- (1) diameter (inches) 2
 - (2) total depth (feet) 1013
 - (3) static water level (feet) Flow below above top of ground.
 - (4) casing Galv. 993
 (material) (depth)
2 if telescope see back.
 (size)
 - (5) screen 20 993
 (length) (depth to top)
2 S. Steel
 (size) (material)
 - (6) pump
 (HP) (yield gpm)
 (type power)
 - (7) electric log NO
 (yes or no)
 (organization running log)
 - (8) how well bottom plugged Aw, Valve


description of formations encountered	from	to
Surface Clay	0	14
SAND	14	50
Blue Clay	50	160
SAND	160	217
Blue Clay	217	235
SAND	235	290
Blue Clay	290	345
SAND	345	410
Blue Clay	410	525
SAND	525	548
Blue Clay	548	705
SAND	705	755
Blue Clay	755	935
SAND	935	1013

CODED

DRILLERS REMARKS: 18 lbs
Pressure

If well telescopes please sketch and show depths.

GROUND LEVEL

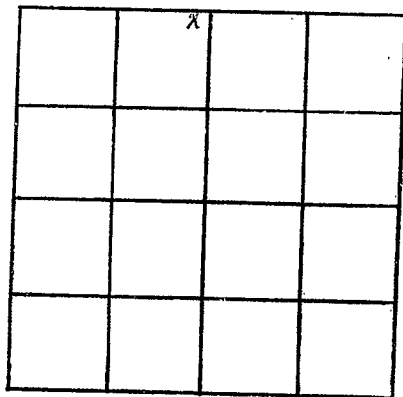

SECTION 21

Please indicate well location X.

ADDITIONAL INFORMATION

If more than one screen,
show locations of each on sketch.