

PEARL RIVER
X 53
11-28-71

MISSISSIPPI
 BOARD OF WATER COMMISSIONERS
 416 North State Street
 Jackson, Mississippi 39201

DEC 15 1971

WATER WELL DRILLERS LOG

MISS. BD. OF
CODED
 Pearl River
 county well located

11-28-71 19 71 PenTom Well Serv
 date well completed firm name

LANDOWNER: Doyle Whitfield

103 CORINTH
Picayune, Miss.
 (mailing address)

description of formations encountered	from	to
Surface Clay	0	23
Sand	23	35
White Clay	35	45
Blue Clay	45	220
SAND	220	255
Blue Clay	255	275
SAND	275	325
Clay	325	390
SAND	390	425
Blue Clay	425	565
Fine Sand	565	610
Blue Clay	610	990
SAND	990	1075

WELL LOCATION:
 sec. 18 T. 6 N. R. 16 E.
 S W
1/2 miles East of Picayune
 (distance) (direction) (nearest town)

WELL PURPOSE: Home
 (home, irrigation, municipal, industrial)

WELL COMPLETION DATA:


- (1) diameter (inches) 2
- (2) total depth (feet) 425 1075
- (3) static water level (feet) Flow ^{below} above top of ground.
- (4) casing 6044 1055
 (material) (depth)
2 If telescope see back.
 (size)
- (5) screen 20 1055
 (length) (depth to top)
2 S. Steel
 (size) (material)
- (6) pump ✓ ✓
 (HP) (yield gpm)
✓
 (type power)
- (7) electric log NO
 (yes or no)
 (organization running log)
- (8) how well bottom plugged B.V. Valve

CODED

DRILLERS REMARKS: 20 LBS.
Pressure

If well telescopes please sketch and show depths.

GROUND LEVEL

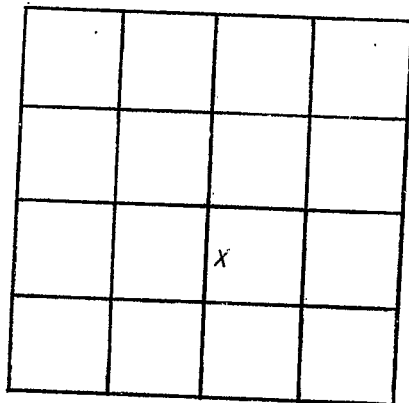

SECTION 18

Please indicate well location X.

ADDITIONAL INFORMATION

If more than one screen,
show locations of each on sketch.