

Pearl River  
X 54  
1-14-72

MISSISSIPPI  
 BOARD OF WATER COMMISSIONERS  
 416 North State Street  
 Jackson, Mississippi 39201

**CODED**

WATER WELL DRILLERS LOG


1-14 1972 Lawton Well Serv Pearl River  
 date well completed firm name county well located

LANDOWNER: <u>R. C. Westbrook</u> <u>Rt. 2</u>	description of formations encountered	from	to
<u>Picayune Miss</u> (mailing address)	<u>Surface Clay</u>	<u>0</u>	<u>24</u>
WELL LOCATION: sec. <u>17</u> T. <u>6</u> S. R. <u>16</u> W. <u>1 1/2</u> miles <u>East</u> of <u>Picayune</u> (distance) (direction) (nearest town)	<u>Sand</u>	<u>24</u>	<u>110</u>
WELL PURPOSE: <u>Home</u> (home, irrigation, municipal, industrial)	<u>Blue Clay</u>	<u>260</u>	<u>268</u>
WELL COMPLETION DATA: <u>4 1/2</u>	<u>Mud</u>	<u>268</u>	<u>285</u>
(1) diameter (inches) <u>2</u>	<u>Blue Clay</u>	<u>285</u>	<u>520</u>
(2) total depth (feet) <u>598</u>	<u>Sand</u>	<u>520</u>	<u>598</u>
(3) static water level (feet) <u>8</u> below top of ground.			
(4) casing <u>Galv.</u> <u>588</u> (material) (depth)			
(5) screen <u>10'</u> <u>588</u> (length) (depth to top)			
(6) pump <u>2</u> <u>S. Steel</u> (size) (material)			
(7) electric log <u>No</u> (yes or no)			
(8) how well bottom plugged <u>B.W. Valve</u>			
DRILLERS REMARKS:			

**CODED**

If well telescopes please sketch and show depths.

GROUND LEVEL

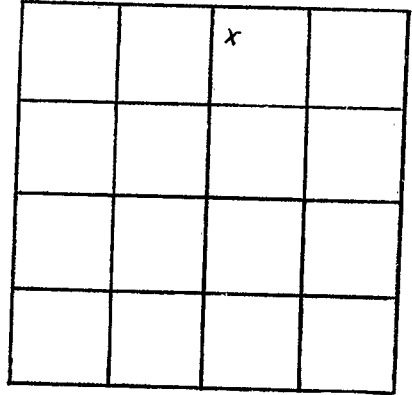

SECTION 17

Please indicate well location X.

ADDITIONAL INFORMATION

If more than one screen,  
show locations of each on sketch.