

Pearl River
X55
10-18-71

MISSISSIPPI
 BOARD OF WATER COMMISSIONERS
 416 North State Street
 Jackson, Mississippi 39201

INDEXED
 MAR 9 1972

WATER WELL DRILLERS LOG

MISS. BD. OF
 WATER COMMISSIONERS

date well completed

19 11 Neil Dumper
 well drilling service

county well located

LANDOWNER:

Walter W. Johnson
Orangeburg, Miss.
 (mailing address)

description of formations encountered

from

to

<u>2 in. gravel</u>	<u>0</u>	<u>2</u>
<u>1/2 in. sand</u>	<u>5</u>	<u>65</u>
<u>1/2 in. clay</u>	<u>55</u>	<u>120</u>
<u>sand, no rock</u>	<u>100</u>	<u>130</u>
<u>blue clay</u>	<u>130</u>	<u>170</u>
<u>blue clay</u>	<u>170</u>	<u>210</u>
<u>hard bottom</u>	<u>170</u>	<u>210</u>
<u>little rocks</u>		

WELL LOCATION:

sec. 18 T 6 N R. 16 E
1/4 miles EAST of Orangeburg
 (distance) (direction) (nearest town)

WELL PURPOSE:

(home, irrigation, municipal, industrial)

WELL COMPLETION DATA:


- (1) diameter (inches) 2
- (2) total depth (feet) 210
- (3) static water level (feet) 15 below above top of ground.
- (4) casing 4 in. (material) (depth) (size) If telescope see back.
- (5) screen 1/2 in. (length) (depth to top) (size) (material)
- (6) pump 1/2 (HP) 500 gpm (yield gpm) (type power)
- (7) electric log (yes or no) no
- (organization running log)

(8) how well bottom plugged plugged

DRILLERS REMARKS:

If well telescopes please sketch and show depths.

GROUND LEVEL

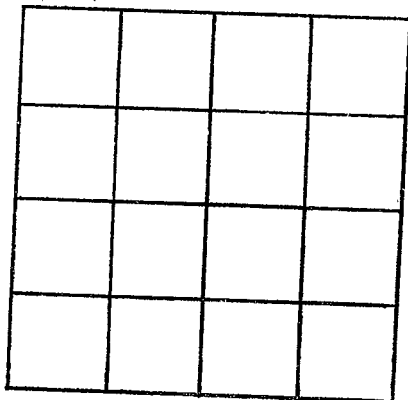

SECTION _____

Please indicate well location X.

ADDITIONAL INFORMATION

If more than one screen, show locations of each on sketch.