

PEARL RIVER
X 56
6-22-72

MISSISSIPPI
 BOARD OF WATER COMMISSIONERS
 416 North State Street
 Jackson, Mississippi 39201

CODED

WATER WELL DRILLERS LOG

6-22 1972 PEARL RIVER WELL DRILLING SERVICE
 date well completed P.O. BOX 117 Pearl River
 LUMPKIN, MISS. county well located

LANDOWNER:	description of formations encountered	from	to
<u>J.A. Ramsay</u> <u>415 Woodglow Cove</u> <u>Picayune Miss.</u> (mailing address)	<u>Surface clay</u>	<u>0</u>	<u>10</u>
	<u>Sand</u>	<u>10</u>	<u>80</u>
WELL LOCATION: sec. <u>8</u> T. <u>6</u> S. R. <u>16</u> E. <u>2</u> miles <u>E.</u> of <u>Picayune</u> (distance) (direction) (nearest town)	<u>Clay</u>	<u>80</u>	<u>140</u>
	<u>Sand</u>	<u>140</u>	<u>210</u>
WELL PURPOSE: <u>home</u> (home, irrigation, municipal, industrial)	<u>Clay</u>	<u>210</u>	<u>460</u>
WELL COMPLETION DATA: (1) diameter (inches) <u>2"</u>	<u>Perfect pump</u>	<u>460</u>	<u>550</u>
(2) total depth (feet) <u>1008'</u>	<u>level sand</u>		
(3) static water level (feet) <u>30</u> <u>below</u> above top of ground.	<u>Clay</u>	<u>550</u>	<u>695</u>
(4) casing <u>galv.</u> (material), (depth)	<u>Sand</u>	<u>695</u>	<u>780</u>
<u>24</u> (size) If telescope see back.	<u>Heaving shale</u>	<u>780</u>	<u>925</u>
(5) screen <u>20'</u> (length), (depth to top)	<u>fine to better</u>	<u>925</u>	<u>1008</u>
<u>24</u> (size), <u>Sh. Steel</u> (material)	<u>sand</u>		
(6) pump (HP) (yield gpm)			
(type power)			
(7) electric log <u>no</u> (yes or no)			
(organization running log)			
(8) how well bottom plugged <u>Johnson</u> <u>BP Valves</u>			
DRILLERS REMARKS: <u>14 lbs.</u> <u>pressure</u>			


CODED

JUN 28 1972

MISSISSIPPI
 WATER COMMISSIONERS

If well telescopes please sketch and show depths.

GROUND LEVEL

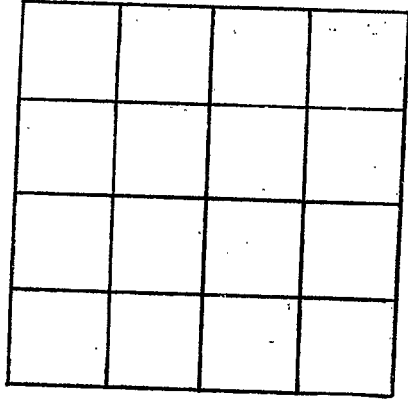

SECTION _____

Please indicate well location X.

ADDITIONAL INFORMATION

A series of horizontal lines for writing additional information, starting below the 'ADDITIONAL INFORMATION' header and extending down to the bottom of the page.

If more than one screen, show locations of each on sketch.