

**Pearl River**  
**X 57**  
**6-1-72**

MISSISSIPPI  
 BOARD OF WATER COMMISSIONERS  
 416 North State Street  
 Jackson, Mississippi 39201

**CODED**

WATER WELL DRILLERS LOG

6-1 1972 72 Penton Well Serv Pearl River  
 date well completed                  firm name                  county well located

LANDOWNER: A.P. Landrum  
Rt. 3, Box 376  
Picayune Miss  
 (mailing address)

WELL LOCATION:  
 sec. 14 T. 6 N. R. 16 E  
                                       S.                                  W.  
4 1/2 miles East of Picayune  
 (distance)    (direction)    (nearest town)

description of formations encountered	from	to
Surface clay	0	18
Sand	18	57
White clay	57	85
Blue clay	85	160
Silt	160	220
Blue clay	220	520
Sand	520	580

WELL PURPOSE: Home  
 (home, irrigation, municipal, industrial)

WELL COMPLETION DATA: 4 1/2

(1) diameter (inches) 2"

(2) total depth (feet) 580

(3) static water level (feet) 12 below  
 top of ground.                  above

(4) casing Galv., 570,  
 (material), (depth),  
2 if telescope see back.  
 (size)

(5) screen 10, 570,  
 (length), (depth to top)  
2, S. Steel  
 (size), (material)

(6) pump ✓, ✓  
 (HP) (yield gpm)  
✓  
 (type power)

(7) electric log NO  
 (yes or no)

(organization running log)

(8) how well bottom plugged Bill. Valve


**CODED**

JUL 7 1972

DRILLERS REMARKS:  
 \_\_\_\_\_  
 \_\_\_\_\_

If well telescopes please sketch and show depths.

GROUND LEVEL

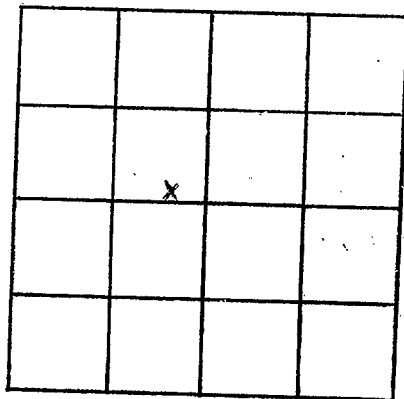

SECTION 14

Please indicate well location X.

ADDITIONAL INFORMATION

If more than one screen,  
show locations of each on sketch.