

**PEARL RIVER**  
**X 58**  
**6-29-72**

MISSISSIPPI  
 BOARD OF WATER COMMISSIONERS  
 416 North State Street  
 Jackson, Mississippi 39201

**CODED**

WATER WELL DRILLERS LOG

6-29 1972 Peaton Well Serv Pearl River  
 date well completed firm name county well located

LANDOWNER: Bill Kendrick  
Rt. 3 Box 271  
Picayune MISS  
 (mailing address)

description of formations encountered	from	to
	Surface clay	0
Sand	28	118
Blue clay	118	185
Sand	185	210
Blue clay	210	520
Sand	520	560

WELL LOCATION:  
 sec. 12 T. 6 N. R. 16 W.  
 S W  
5 miles East of Picayune  
 (distance) (direction) (nearest town)

WELL PURPOSE: Home  
 (home, irrigation, municipal, industrial)

WELL COMPLETION DATA:

- (1) diameter (inches) 2
- (2) total depth (feet) 560
- (3) static water level (feet) 19 below above top of ground.
- (4) casing Galv 545  
 (material) (depth)  
2 If telescope see back.  
 (size)
- (5) screen 15 545  
 (length) (depth to top)  
2 3 Steel  
 (size) (material)
- (6) pump 1 12  
 (HP) (yield gpm)  
Elec  
 (type power)
- (7) electric log NO  
 (yes or no)  
 (organization running log)
- (8) how well bottom plugged Bill Valve


**CODED**

DRILLERS REMARKS:

**7**

If well telescopes please sketch and show depths.

GROUND LEVEL

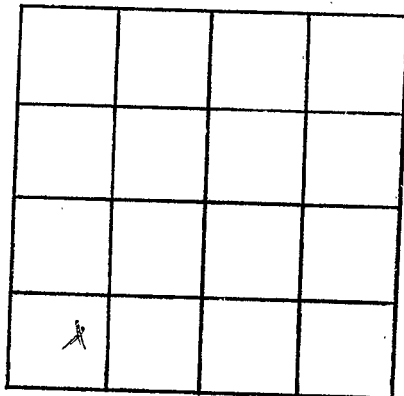

SECTION 12

Please indicate well location X.

ADDITIONAL INFORMATION

If more than one screen,  
show locations of each on sketch.