

PEARL RIVER
X59
6-28-72

MISSISSIPPI
 BOARD OF WATER COMMISSIONERS
 416 North State Street
 Jackson, Mississippi 39201

CODED

WATER WELL DRILLERS LOG

6-28 1972 Earl Penton water well from Pearl River
 date well completed firm name county well located

LANDOWNER:
James Simson
Picayune miss.
 (mailing address)

description of formations encountered	from	to
<u>Red clay</u>	<u>0</u>	<u>5</u>
<u>whit. clay</u>	<u>5</u>	<u>10</u>
<u>coarse white ss</u>	<u>10</u>	<u>59</u>

WELL LOCATION:
 sec. 8 T. 6 N. R. 16 E.
4 miles N East of Picayune
 (distance) (direction) (nearest town)

WELL PURPOSE: Home
 (home, irrigation, municipal, industrial)

- WELL COMPLETION DATA:
- (1) diameter (inches) 4 1/2
 - (2) total depth (feet) 39
 - (3) static water level (feet) 11 below above top of ground.
 - (4) casing Pvc, 34'
 (material) (depth)
2" if telescope see back.
 (size)
 - (5) screen 2', 34'
 (length) (depth to top)
2" PVC
 (size) (material)
 - (6) pump 1/2, 400
 (HP) (yield gpm)
Elect
 (type power)
 - (7) electric log
 (yes or no)

CODED

(organization running log)
 (8) how well bottom plugged skoe


JUL 21 1972
 JUL 21 1972

MISS. BD. OF
 WATER COMMISSIONERS

DRILLERS REMARKS:

If well telescopes please sketch and show depths.

GROUND LEVEL

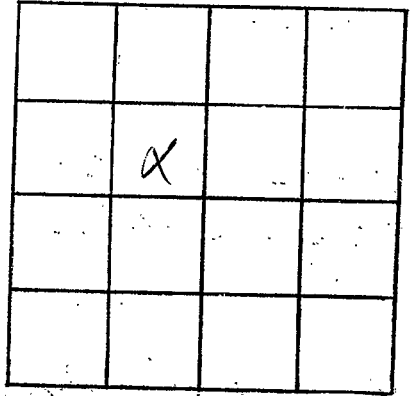

SECTION 8

Please indicate well location X.

ADDITIONAL INFORMATION

If more than one screen,
show locations of each on sketch.