

PEARL RIVER  
X 61  
8-11-72

MISSISSIPPI  
BOARD OF WATER COMMISSIONERS  
416 North State Street  
Jackson, Mississippi 39201

**CODED**

WATER WELL DRILLERS LOG

NEEL LUMPKIN WELL DRILLING SERVICE  
P. O. BOX 117  
Lumberton, MISS.

county well located Pearl River

8-11-72  
date well completed

LANDOWNER: <u>Joe Juan Lumpkin</u> <u>Picayune, Miss.</u> <u>Route</u> (mailing address)	description of formations encountered	from	to
	<u>Surface clay</u>	<u>0</u>	<u>20</u>
	<u>sand</u>	<u>20</u>	<u>70</u>
	<u>white clay</u>	<u>70</u>	<u>90</u>
	<u>good sand</u>	<u>90</u>	<u>151</u>

WELL LOCATION:  
sec. 4 T. 6 R. 16  
5 miles NE of Picayune  
(distance) (direction) (nearest town)

WELL PURPOSE: Home  
(home, irrigation, municipal, industrial)

- WELL COMPLETION DATA:
- (1) diameter (inches) 2"
  - (2) total depth (feet) 151'
  - (3) static water level (feet) 38 below above top of ground.
  - (4) casing galv. (material), (depth)  
2" if telescope see back. (size)
  - (5) screen 5' (length), (depth to top)  
2" (size), St. Steel (material)
  - (6) pump 1/2 (HP), 550 gph (yield gpm)  
electric (type power)
  - (7) electric log no. (yes or no)

**CODED**

(organization running log)

(8) how well bottom plugged Johnson  
R.P.V.


DRILLERS REMARKS:

AUG 10 1972

MISS. BD. OF  
WATER COM.

If well telescopes please sketch and show depths.

GROUND LEVEL

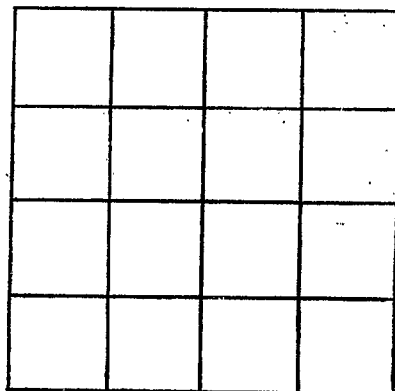

SECTION \_\_\_\_\_

Please indicate well location X.

ADDITIONAL INFORMATION

If more than one screen,  
show locations of each on sketch.