

PEARL RIVER  
 X 62  
 7-21-72

CODED

MISSISSIPPI  
 BOARD OF WATER COMMISSIONERS  
 416 North State Street  
 Jackson, Mississippi 39201

WATER WELL DRILLERS LOG

7-31 1972 Peniton Well Serv Pearl River  
 date well completed firm name county well located

LANDOWNER: A. V. Werner  
 Rt 3  
 Picayune MISS  
 (mailing address)

WELL LOCATION:  
 sec. 13 T. 6 N R. 16 E  
 S W  
 6 miles East of Picayune  
 (distance) (direction) (nearest town)

WELL PURPOSE: Home  
 (home, irrigation, municipal, industrial)

WELL COMPLETION DATA: 4 1/2  
 (1) diameter (inches) 2  
 (2) total depth (feet) 578  
 (3) static water level (feet) 20 below  
 top of ground.  
 (4) casing Galv, 568  
 (material) (depth)  
 2 if telescope see back.  
 (size)  
 (5) screen 10', 568  
 (length) (depth to top)  
 #12 2, S. Steel  
 (size) (material)  
 (6) pump 1 13  
 (HP) (yield gpm)  
 Elec  
 (type power)  
 (7) electric log NO  
 (yes or no)

(organization running log)

(8) how well bottom plugged BW Valve

description of formations encountered	from to	
Surface Clay	0	14
Sand	14	63
White Clay	63	85
Blue Clay	85	360
Mud	360	375
Blue Clay	375	575
Sand	575	578


AUG 29 1972

MISS. STATE UNIV.  
 WATER COMM.

DRILLERS REMARKS:

If well telescopes please sketch and show depths.

GROUND LEVEL

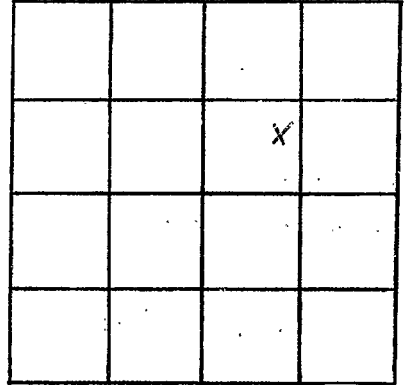

SECTION 13

Please indicate well location X.

ADDITIONAL INFORMATION

If more than one screen,  
show locations of each on sketch.