

PEARL RIVER
 X63
 8-17-72

MISSISSIPPI
 BOARD OF WATER COMMISSIONERS
 416 North State Street
 Jackson, Mississippi 39201

CODED

WATER WELL DRILLERS LOG

8/17/72 date well completed 1972 Pearl River county well located
 B. J. 2. Carriere, Miss. firm name


LANDOWNER: <u>Tommy Morris</u>	description of formations encountered	from	to
(mailing address)			
<u>B. J. 2. Carriere, Miss.</u>	<u>white shale</u>	<u>0</u>	<u>26</u>
	<u>(white sand)</u>	<u>26</u>	<u>48</u>
	<u>blue shale</u>	<u>48</u>	<u>160</u>
	<u>blue sand</u>	<u>48</u>	<u>180</u>
WELL LOCATION:			
sec. <u>10</u> T. <u>6</u> N. R. <u>16</u> E. S. <u>W</u>			
<u>4</u> miles <u>E</u> of <u>Carriere</u>			
(distance) (direction) (nearest town)			
WELL PURPOSE: <u>home</u>			
(home, irrigation, municipal, industrial)			
WELL COMPLETION DATA:			
(1) diameter (inches) <u>2 1/2</u>			
(2) total depth (feet) <u>180</u>			
(3) static water level (feet) <u>42</u> below top of ground.			
(4) casing <u>galv.</u> <u>175</u>			
(material) (depth)			
(size) if telescope see back.			
(5) screen (length) (depth to top)			
<u>2x5</u> <u>shells</u>			
(size) (material)			
(6) pump <u>1</u> <u>660</u>			
(HP) (yield gpm)			
<u>Elect</u>			
(type power)			
(7) electric log (yes or no)			
(organization running log)			
(8) how well bottom plugged <u>Sand Shark</u>			
DRILLERS REMARKS:			

CODED

SEP 21 1972

If well telescopes please sketch and show depths.

GROUND LEVEL

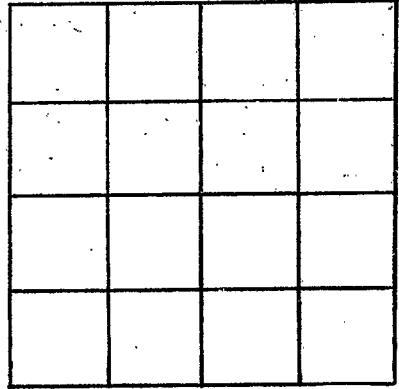

SECTION _____

Please indicate well location X.

ADDITIONAL INFORMATION

If more than one screen, show locations of each on sketch.